


0092

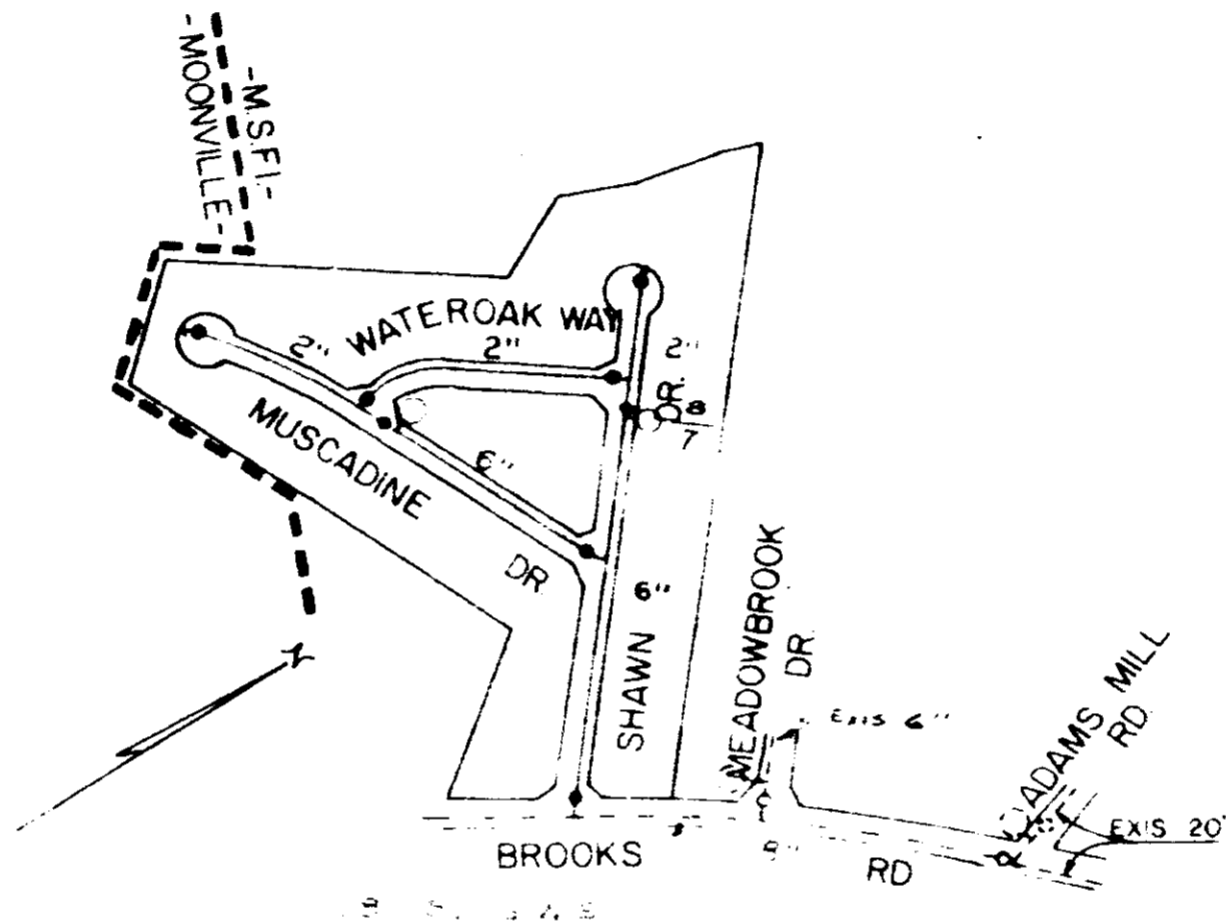

NOTE

ALL 6" & 2" VALS OPEN LT.  
 ALL 2" VALS OPEN RT.

Material List

6" C. I. Pipe	-	1,250'±
2" Galv. Pipe	-	1,190'±
6" Valves	-	4
2" Valves	-	5
Fire Hydrants	-	2

RUSTIC ESTATES

FEBRUARY 1974 SCALE 1"=400'  
 BLK BK M61-1-3 & 31

Exxonity Properties, Inc  
 Commissioners of Public Works  
 of the City of Greenville, S. C.  
 June 11, 1974

RECORDED AUG 1 '74 3181

4328 RV-2