

0697

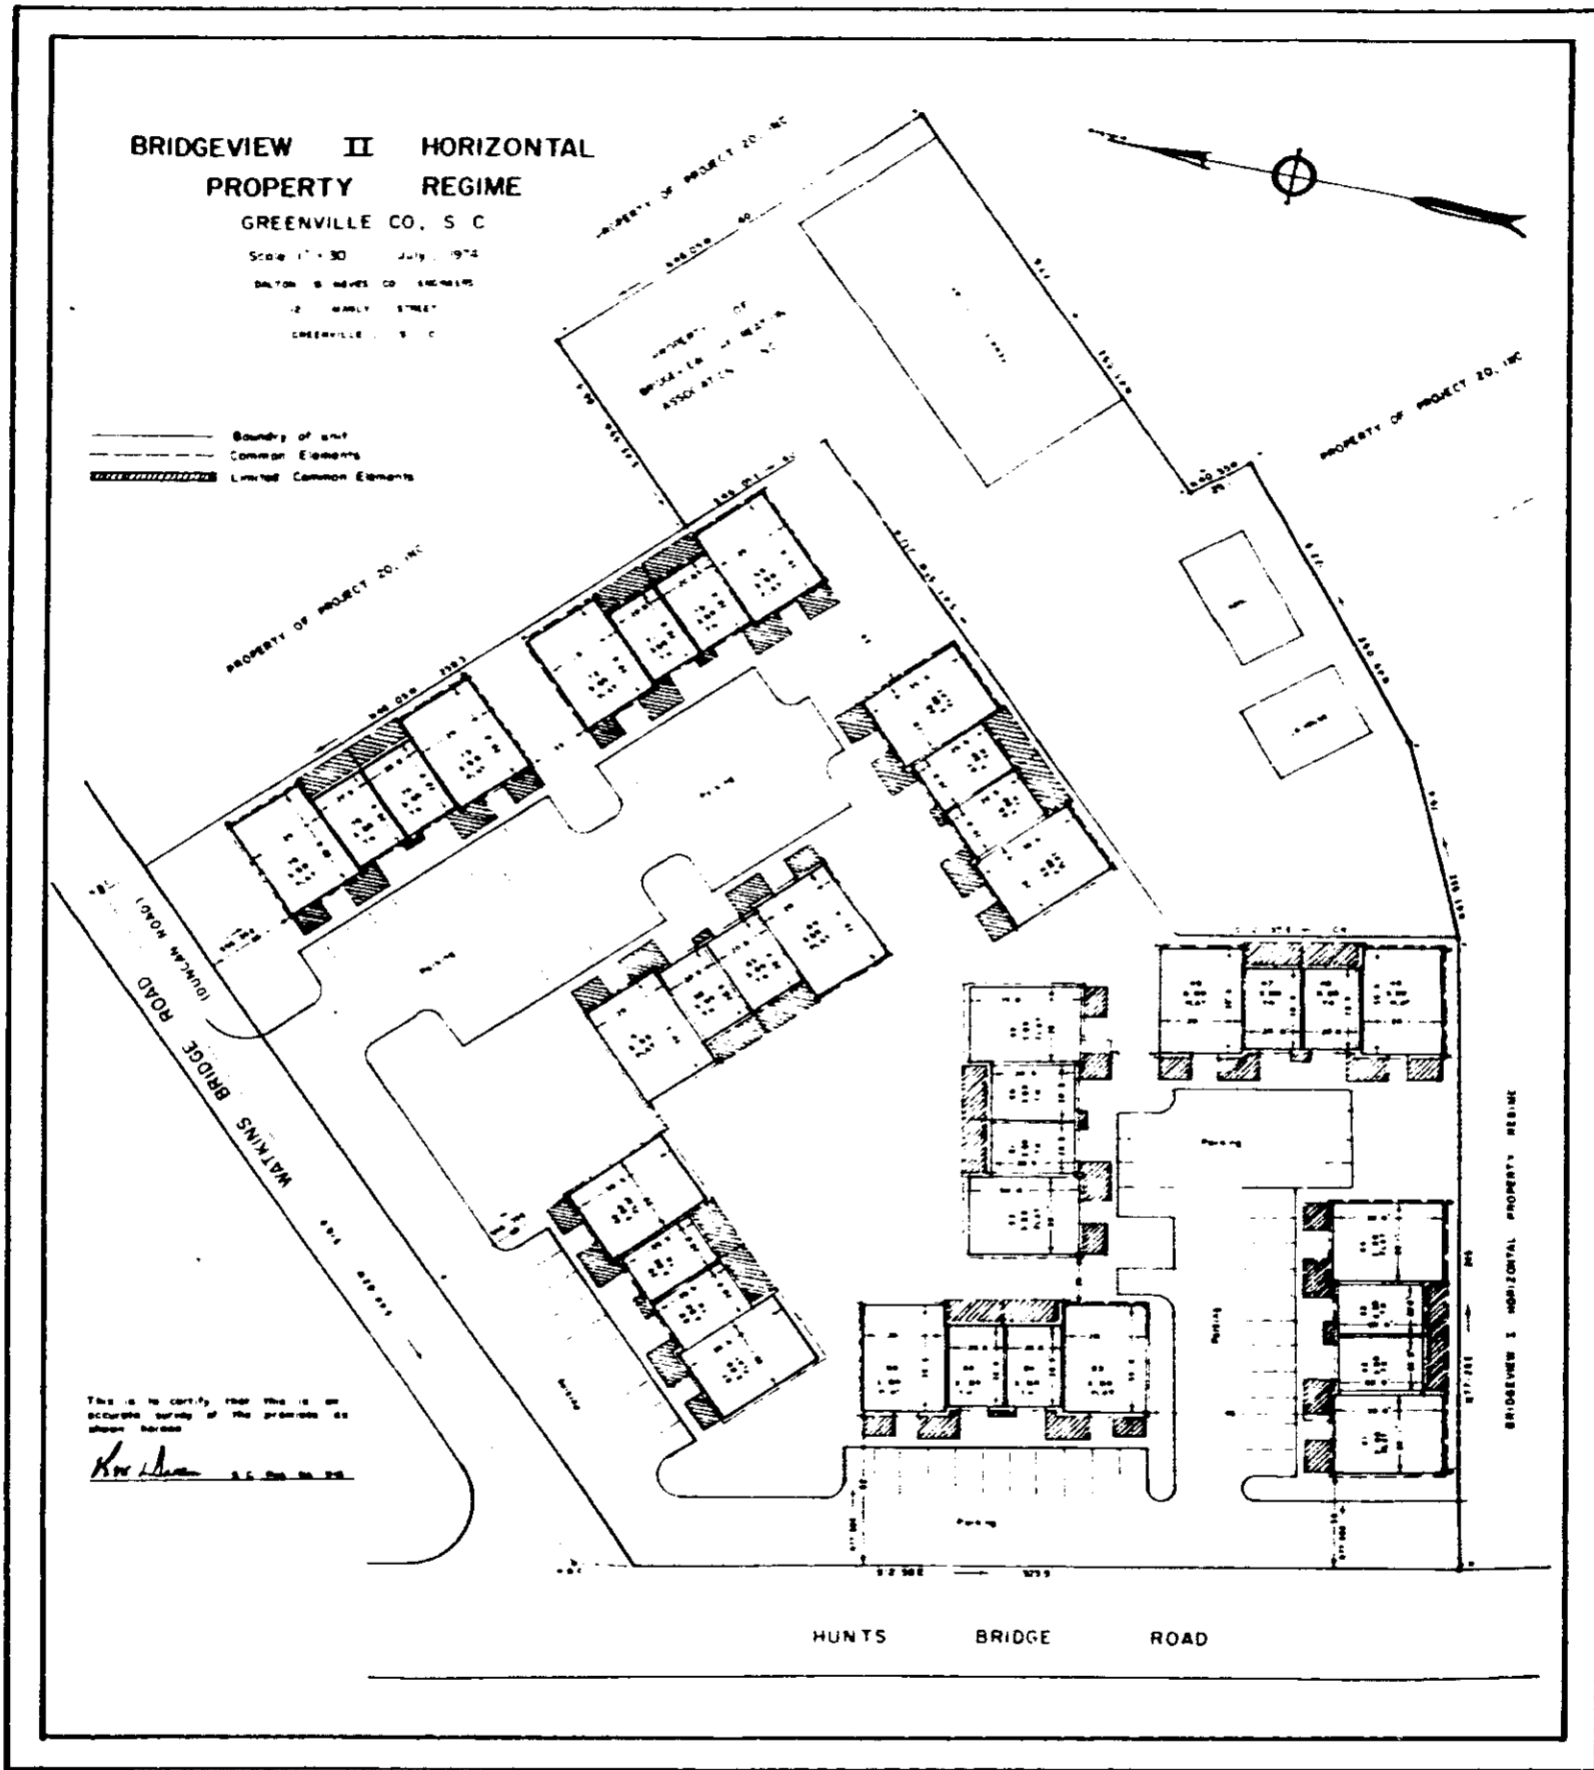


EXHIBIT B  
Sheet 1 of 3

4328 RV-2