

INCLEWOOD HORIZONTAL PROPERTY REGIME









Sheet
11

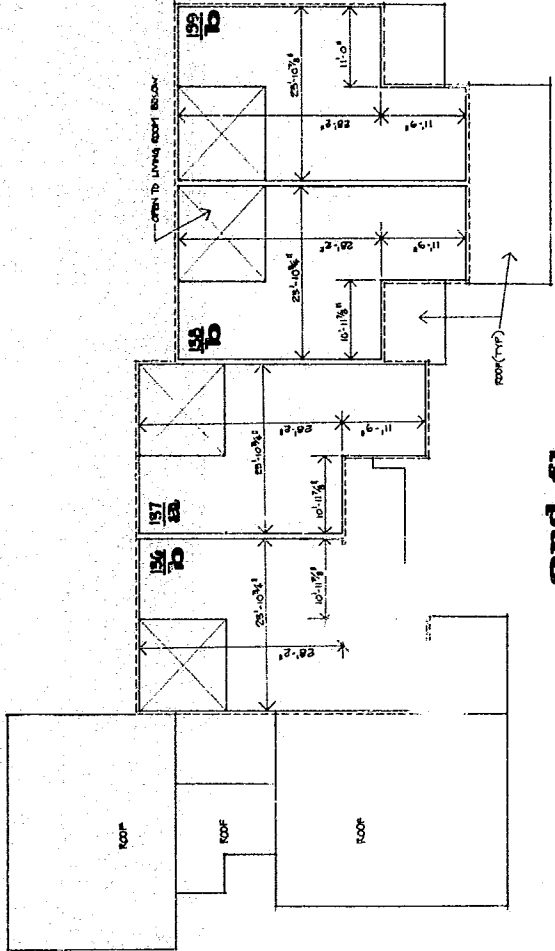


2nd fl.

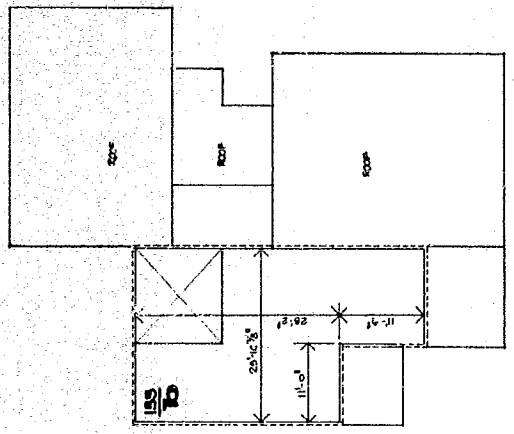

2nd fl.

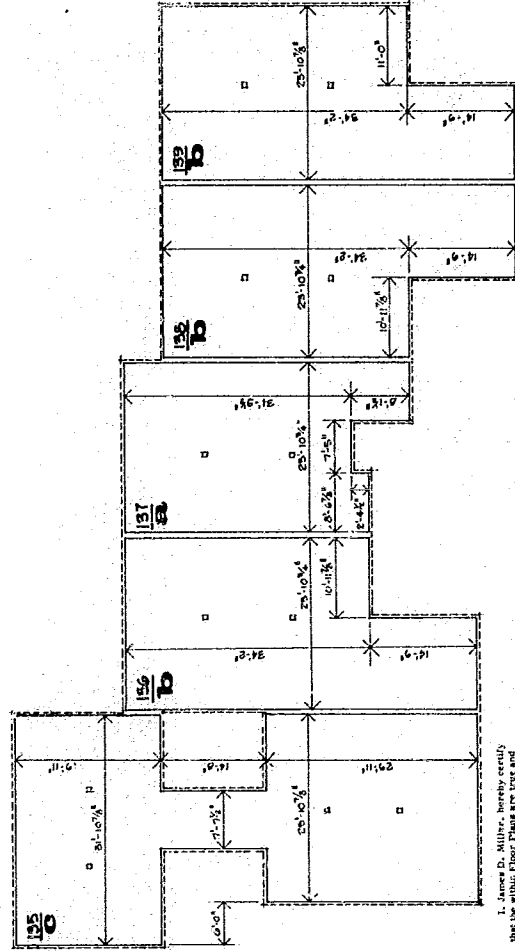

1st fl.

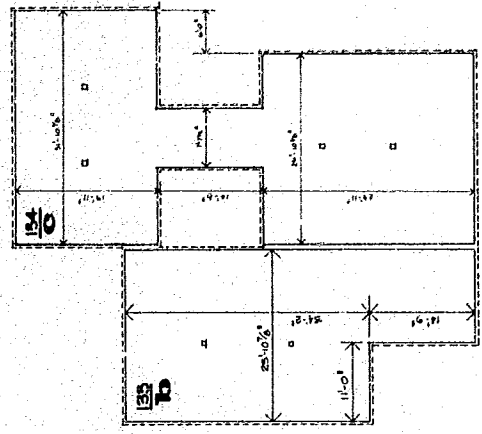

1st fl.




