

Name and Post Office Address of Grantor _____
File No. _____

Toll Line SOUTH CAROLINA HIGHWAY 124 (PENDLETON STREET)
(Name)

or Exchange Line GREENVILLE
tributary to (Exchange)

The Property is bounded where the line enters and leaves this property by the property of:
PENDLETON STREET on the NORTH

and _____ on the _____

Authority 543-1993 Classification 45-C


Area GREENVILLE

Approved _____

Title _____



See map
11945 *
NOV 4 1975

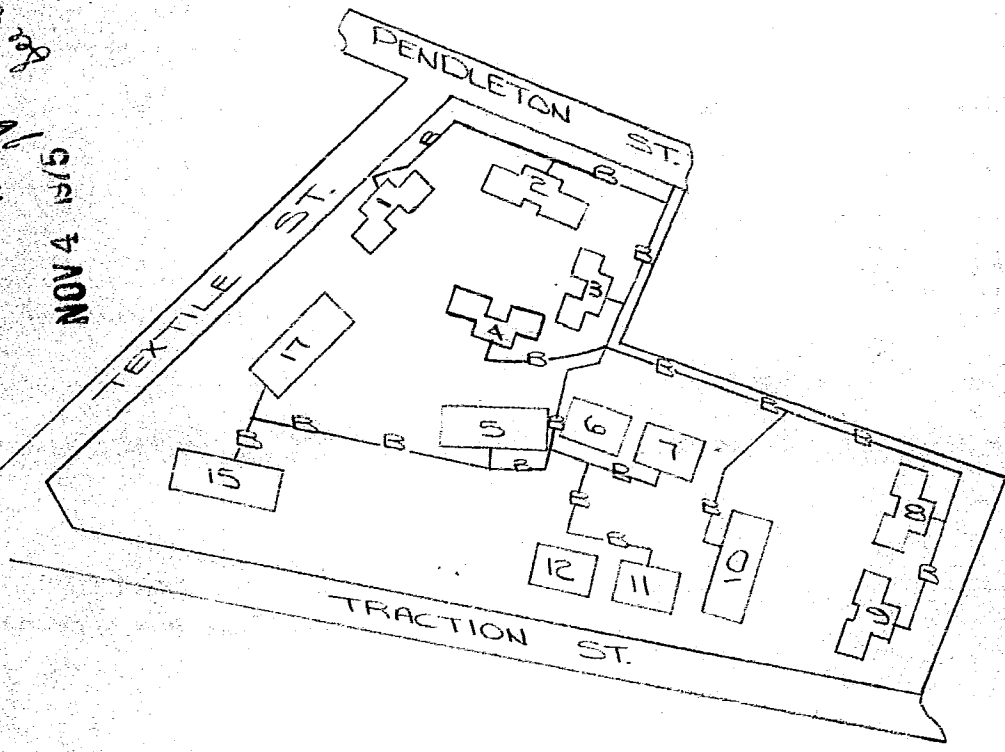

Filed for record in the office of
the R. M. C. for Greenville
County, S. C. at 2:31 o'clock
P. M. Nov. 4, 1975
and recorded in Deed Book
1026 at page 758

R. M. C. for G. Co. S. C.

RECORDED **NOV 4 '75** At 2:31 P.M. **11945**

Housing Authority of Greenville
To
Southern Bell Tel. & T. Co.

Plus Examined

