


0476

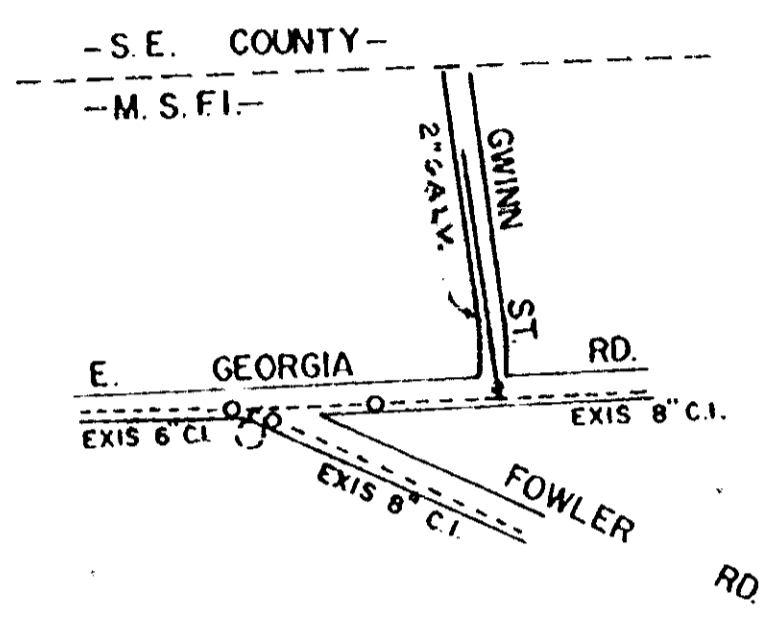

GWINN ST.
 OCT. 1975 SCALE 1" = 400'

Material List:

- 2" Galv. Pipe - 480'
- 2" Valve - 1

J. B. Jones
 to
 Commissioners of Public Works
 of the City of Greenville, S. C.
 October 22, 1975
 BLK. BOOK No. 317-1-12

RECORDED NOV 19 '75

at 1:29 P.M.

13352

4328 RV-2