

Name and Post Office Address of Grantor: **John and Alex Kiriakides**
Roper Mountain Road
Greenville, South Carolina

To: _____
 Line _____ (Name)
 or
 Exchange Line _____ (Exchange)
 tributary to _____


The Property is bounded where the line enters and leaves this property by the property of:
Pine Knoll Drive on the **West**
 and **U. S. Highway 29** on the **South**

Authority _____ Classification **945C**

Area **South Carolina**

Approved: *[Signature]*
District Engineer

Title _____

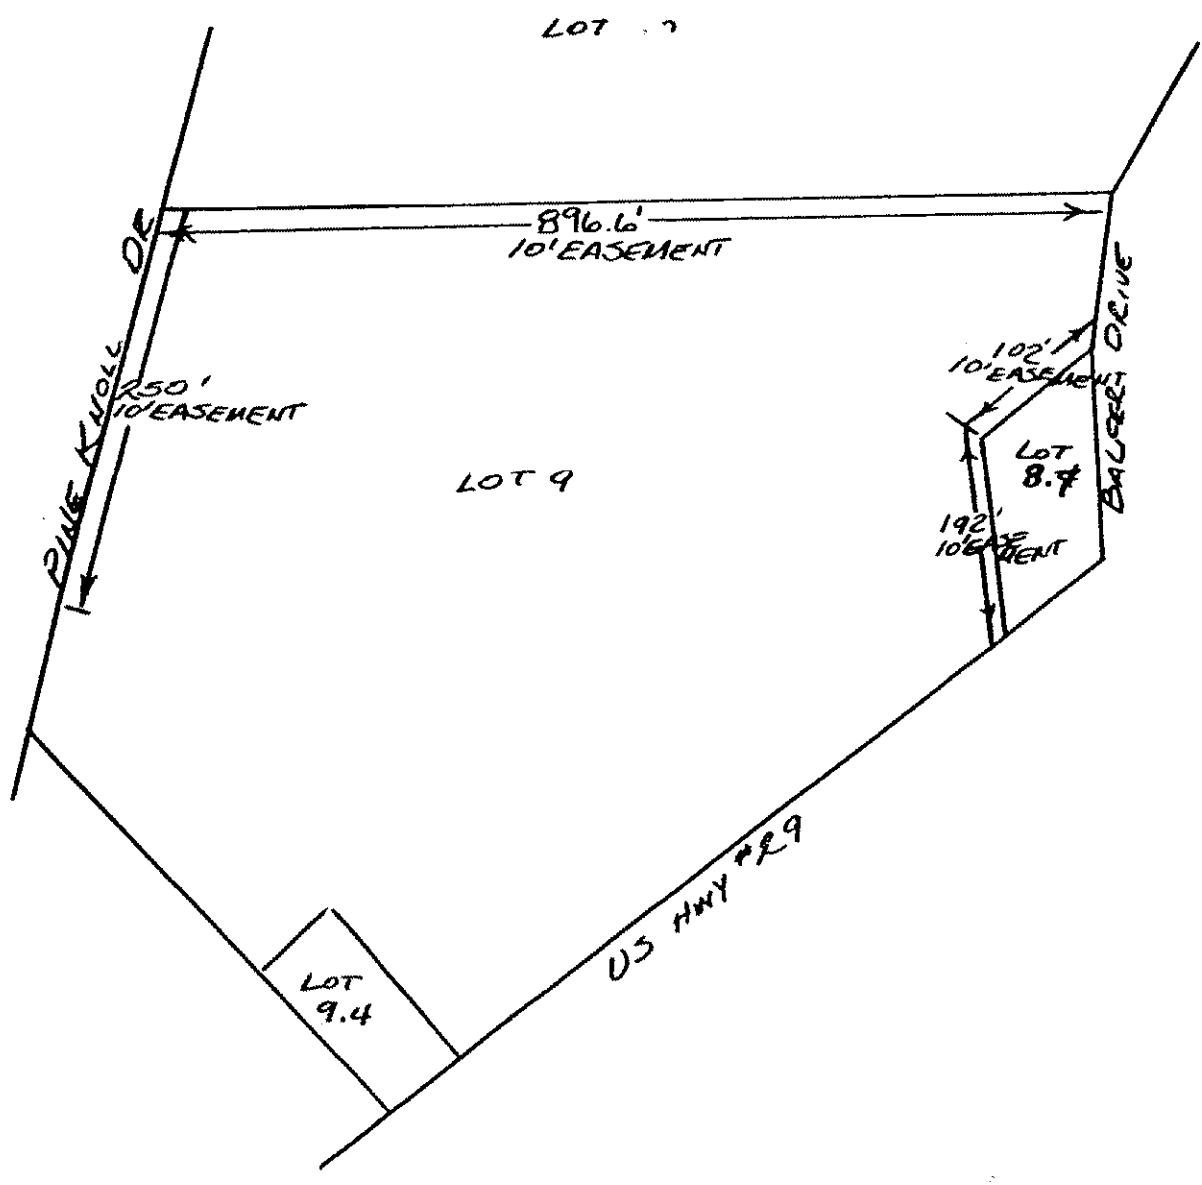

APR 9 1076
 25961

RECORDED APR 9 '76 At 1:09 P.M.

25961

Handwritten note: Mr. Cassin

Handwritten notes:
 Alex Kiriakides
 John Kiriakides
 Southern Bell Telephone & Telegraph Co.

Filed for record in the office of the R. M. C. for Greenville County, S. C. at 1:09 P.M. April 9, 1976 and recorded in Deed Book 103L at page 178 R. M. C. for Greenville, S. C.