


0 2 5 9



va 1035 259

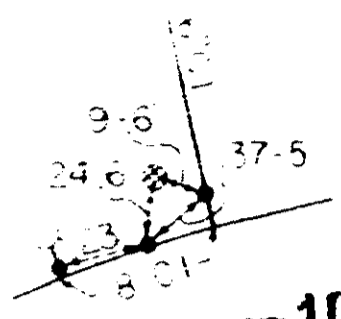

NOTE ALL 6" VALVES OPEN RIGHT  
 ALL 2" VALVES OPEN LEFT  
 ALL FIRE HYDRANTS TO BE 3-WAY & OPEN RIGHT


WOODALL SUBD.  
 DECEMBER, 1975 SCALE 1"=400'  
 BLK BK 5426-1-1

Franklin-Exteriors, Inc.  
 Commissioners of Public Works  
 of the City of Greenville, S. C.  
 March 25, 1976

RECORDED APR 26 '76 at 3:40 P.M. 27511

4328 RW-23