


Name and Post Office Address of Grantee LENA L. KELLY  
DUNCAN P.O.

Toll Line or Exchange line tributary to GREEN

The Property is bounded where the line enters and leaves this property by the property of:  
Maple Creek on the South  
and Smith Estate on the North  
Authority RM 43003 Classification 94-C

Area \_\_\_\_\_  
Approved \_\_\_\_\_  
Title \_\_\_\_\_

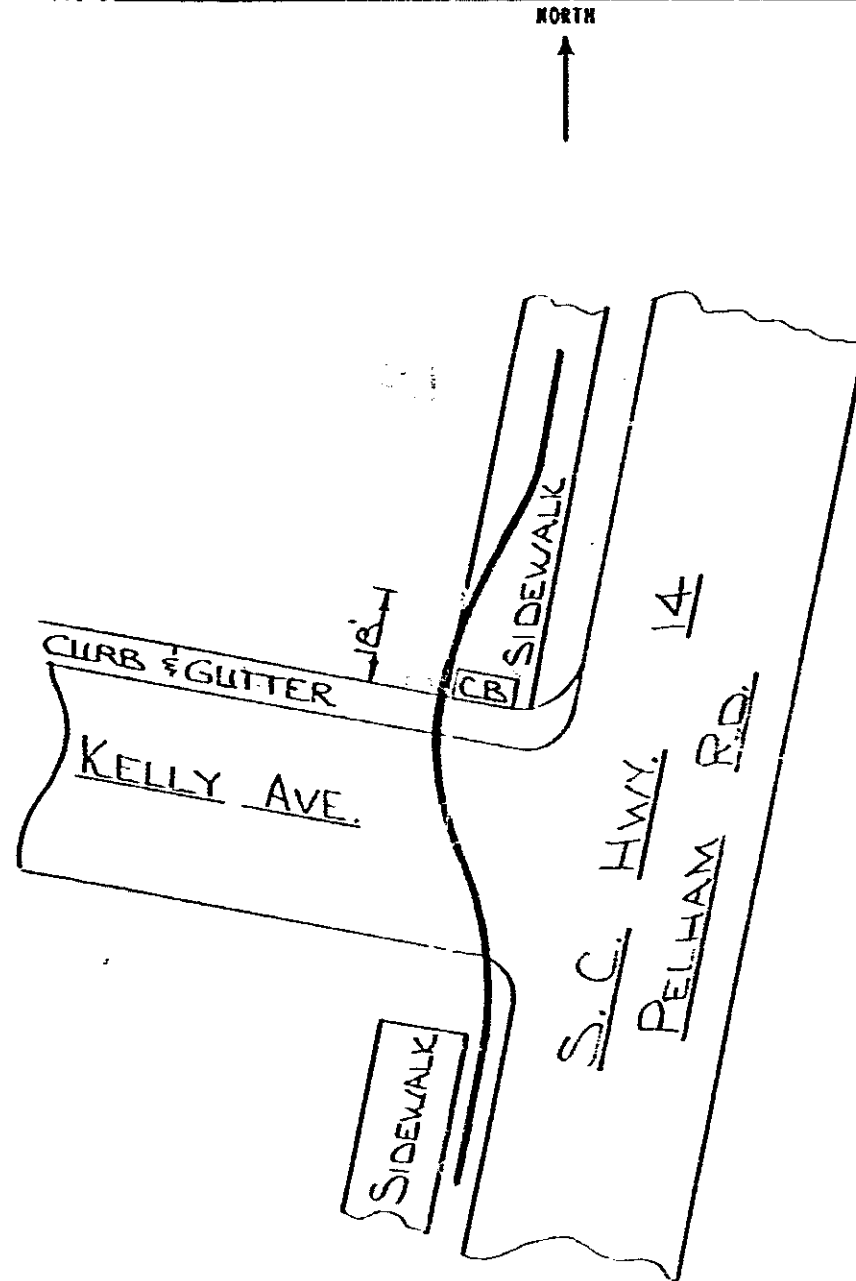

RECORDED JUL 9 '76 At 11:27 A.M.

807

Filed for record in the office of  
the R. M. C. for Greenville  
county, S. C. at 11:27 o'clock  
A.M. July 9, 1976  
and recorded in Deed Book  
1039 at page 128

R. M. C. for G. Co. S. C.

*Handwritten notes:*  
JUL 9 '76  
4328 RV-2

4328 RV-2