


Name and Post Office Address of Grantor Ira A. Giles, Jr.
124 Aberdeen Drive
Greenville, South Carolina

Toll Line _____ (Name)
 or Exchange Line Greenville (Exchange)
 tributary to _____

The Property is bounded where the line enters and leaves this property by the property of:
Willie Burnside on the Northeast
 and Glenn Road on the Southwest

Authority S-8170 Classification 94-C
 Area Greenville, South Carolina

Approved _____
 Title _____

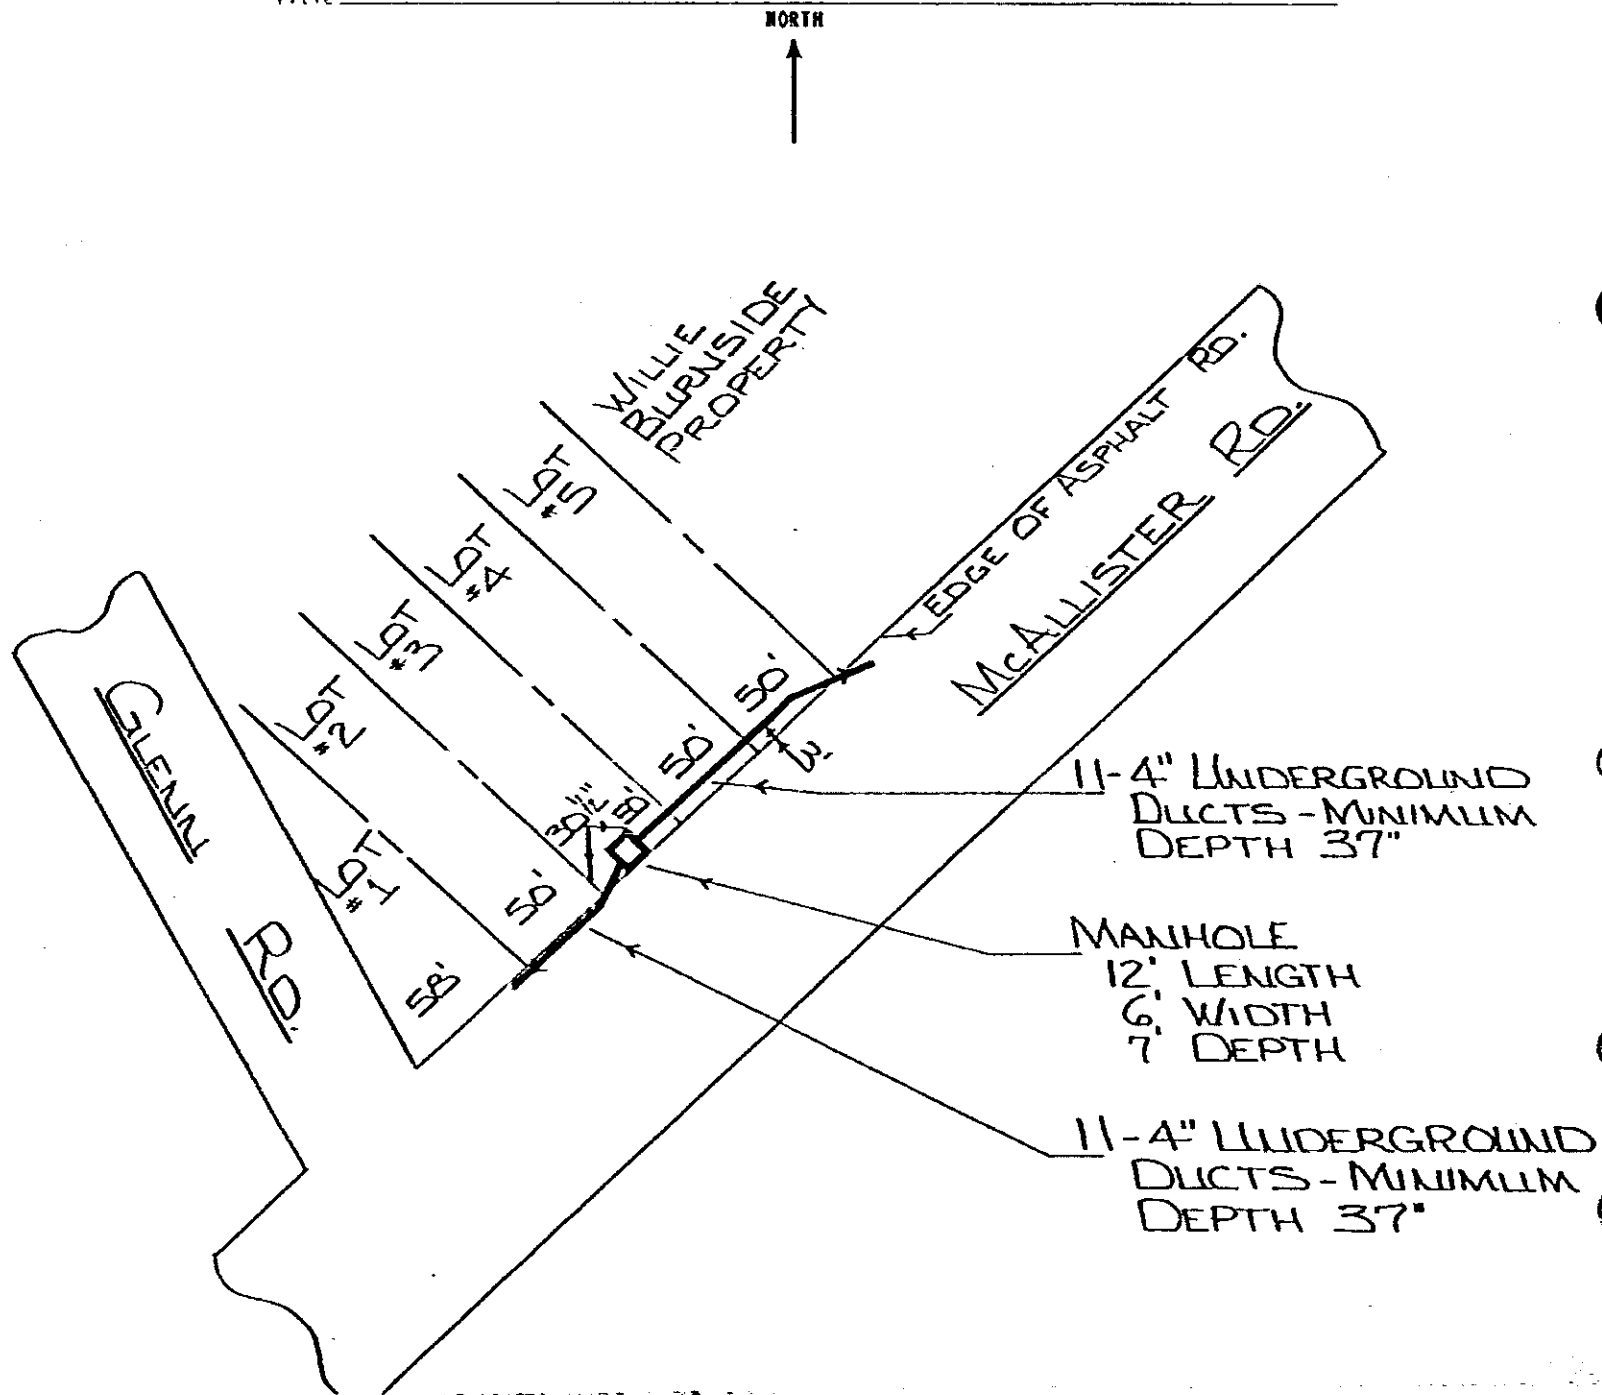

RECORDED JUL 9 '76 At 11:28 A.M.

807

JUL 9 '76

R. M. C. for G. Co. S. C.

Filed for record in the office of
 the R. M. C. for Greenville
 county, S. C. at 11:28 o'clock
 A. M. July 9, 1976
 and recorded in Deed Book
 1039 at page 420

S. Burnside July 10

W. S. 807K

(2)

4328 RV-2