


U.S. HWY. 276

VOL. 1054 PAGE 138

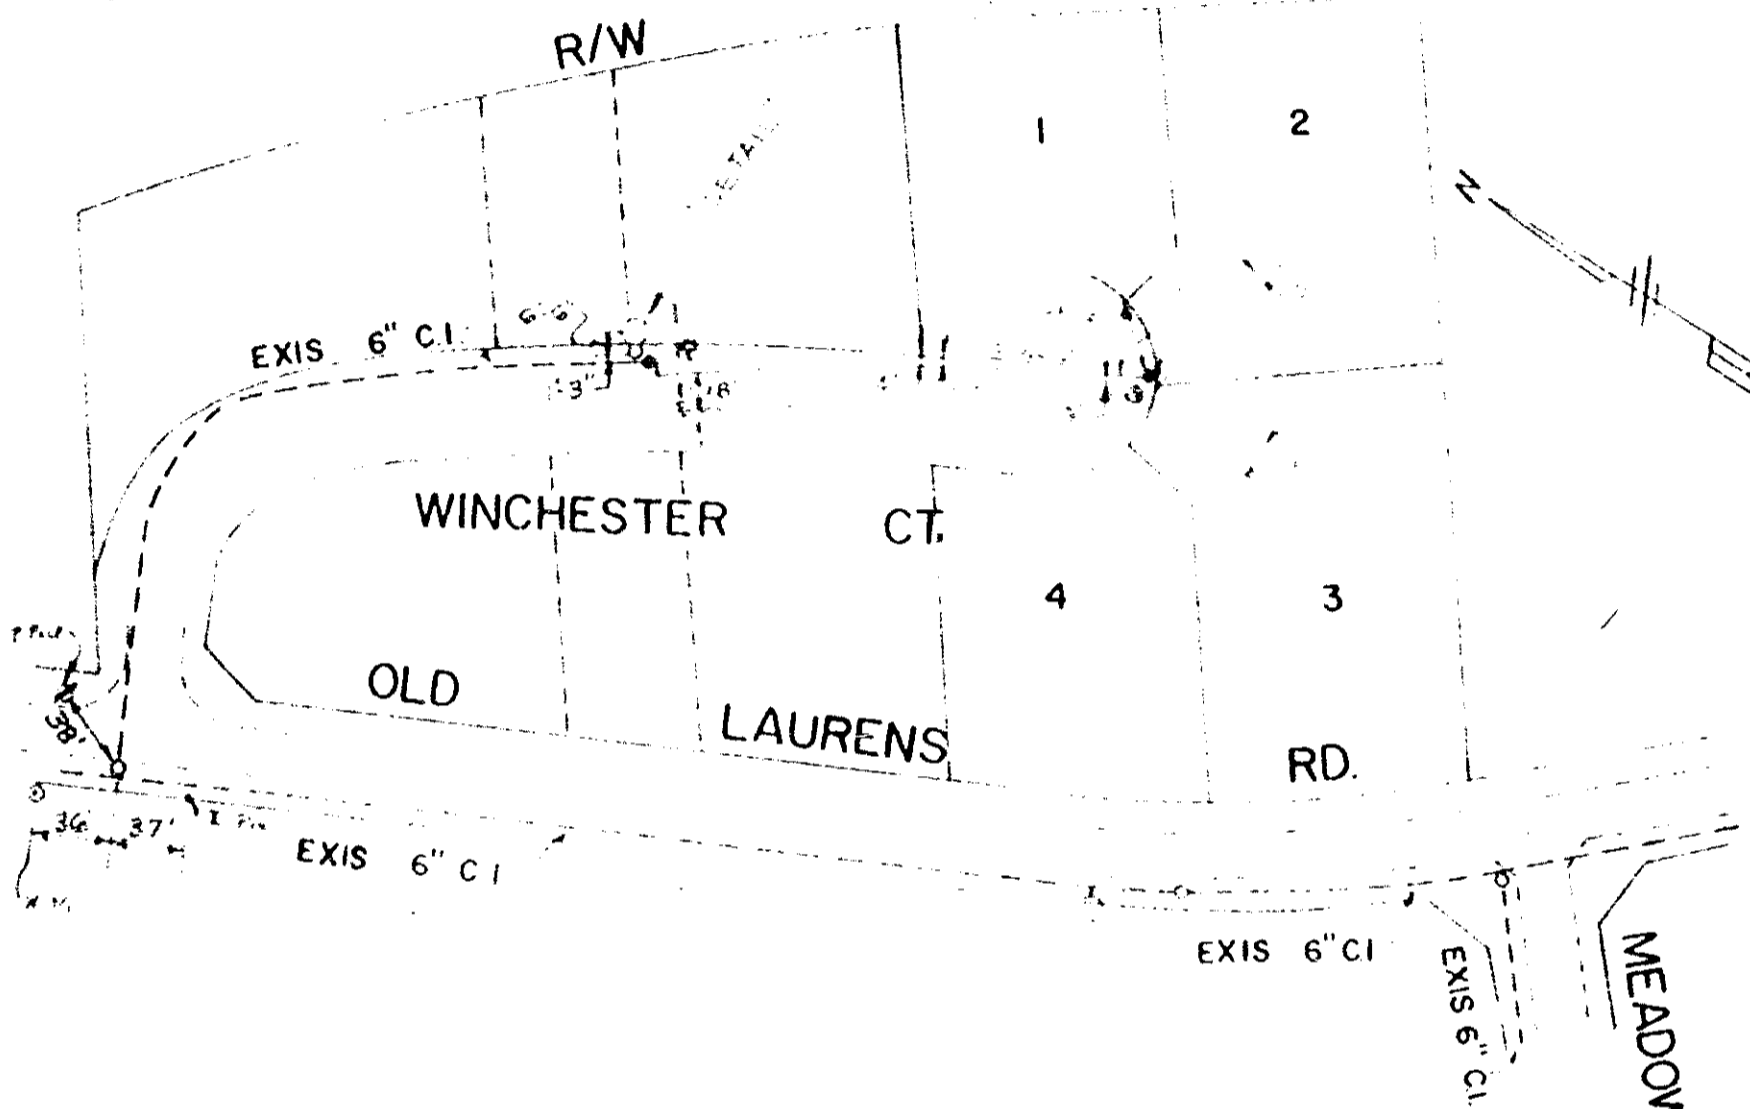

NOTE: ALL VALS OPEN LEFT

OAKTREE PLAZA SEC-2
FEB, 1977 SCALE 1" = 100'

Recorded April 5, 1977 at 4:28 P.M.

26595

0138

4328 RV-2