


*EXHIBIT A*

14167-10-10

~~CONFIDENTIAL~~ CIVILIAN DEFENSE ELEMENTS

FOUNDATION PLAN      CURTAIN WALL NO.

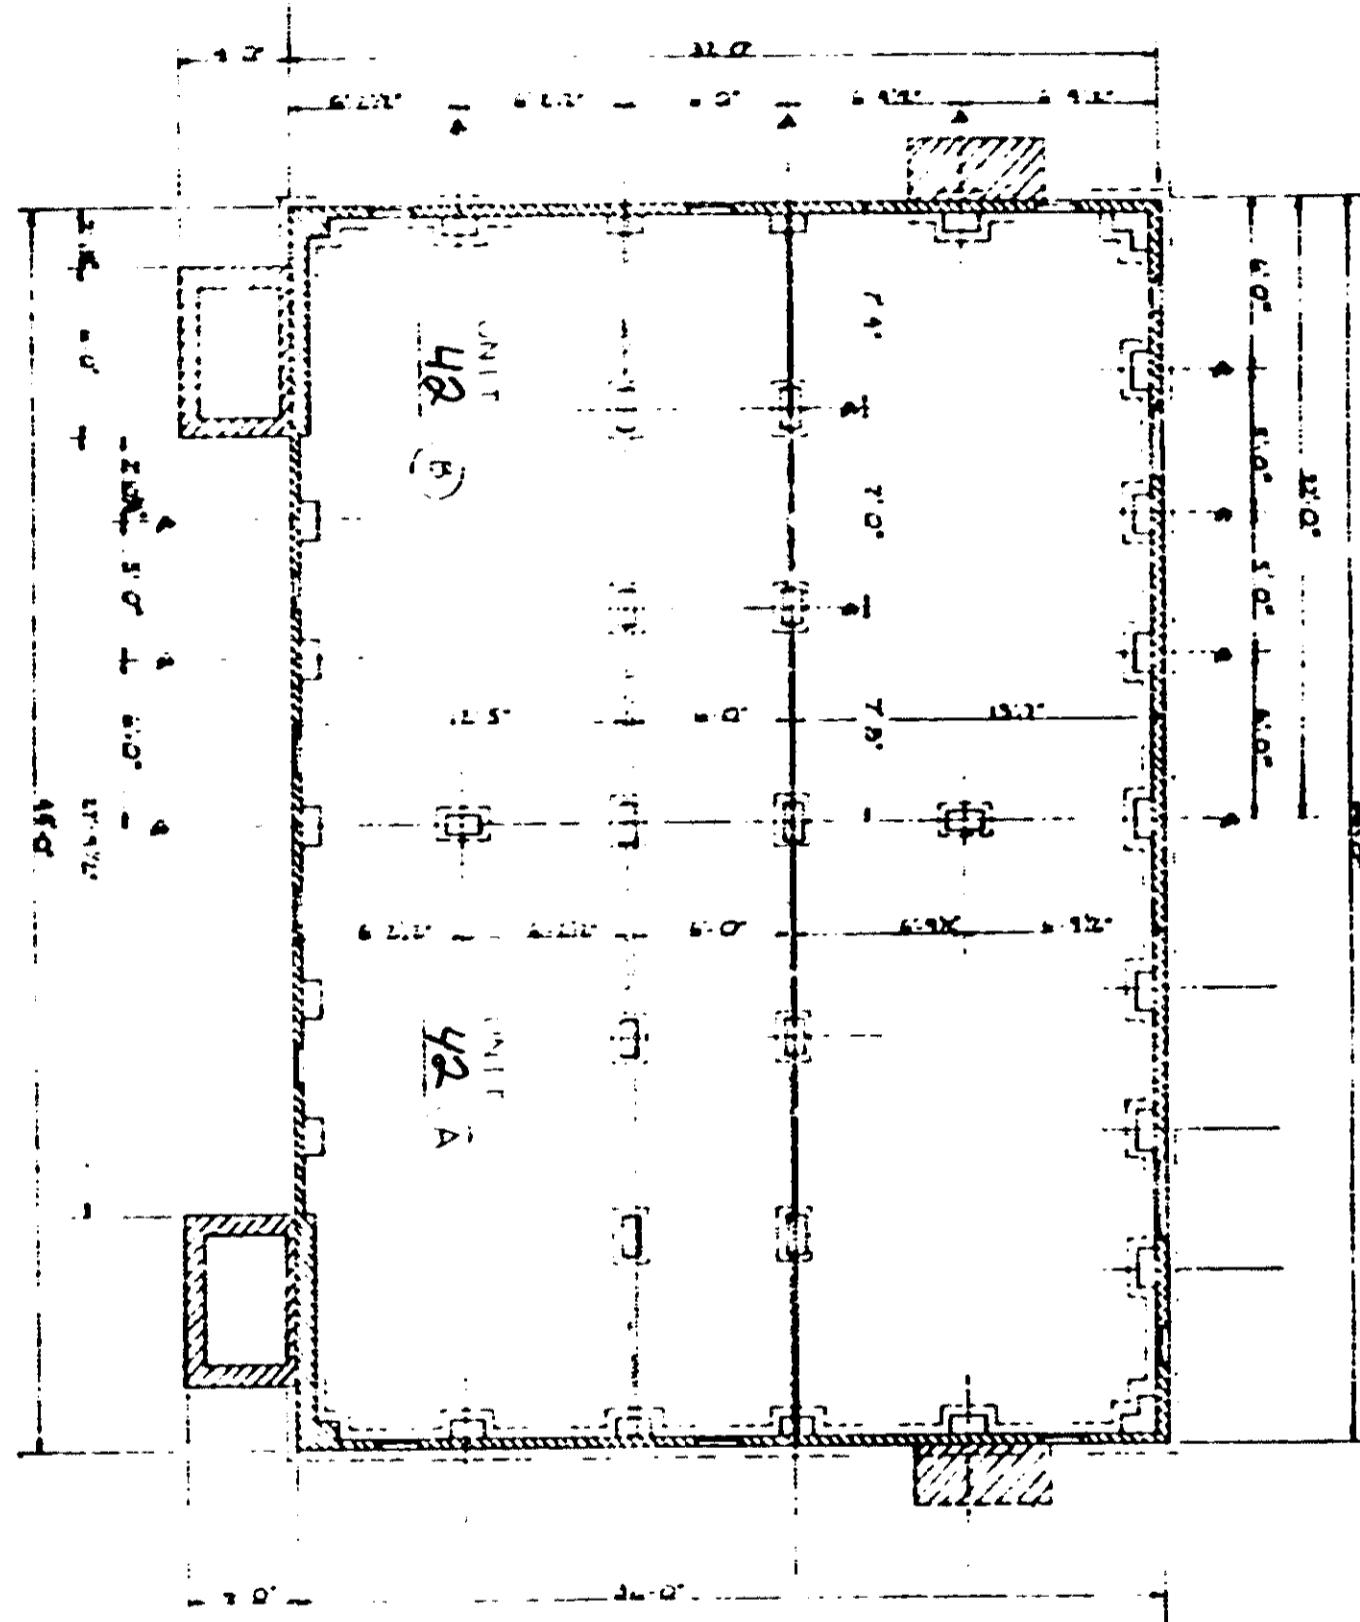

CERTIFICATE

I, Wade H. Barber, do hereby certify  
that these plans fully depict within  
reasonable construction tolerances the  
layout, location, letter identification  
and dimensions of the buildings and  
courtyards contained therein.

*Wade H. Barber*



DOVER TOWNHOUSES No. 42  
HORIZONTAL PROPERTY REGIME

[4328 RV.2]