


EXHIBIT A

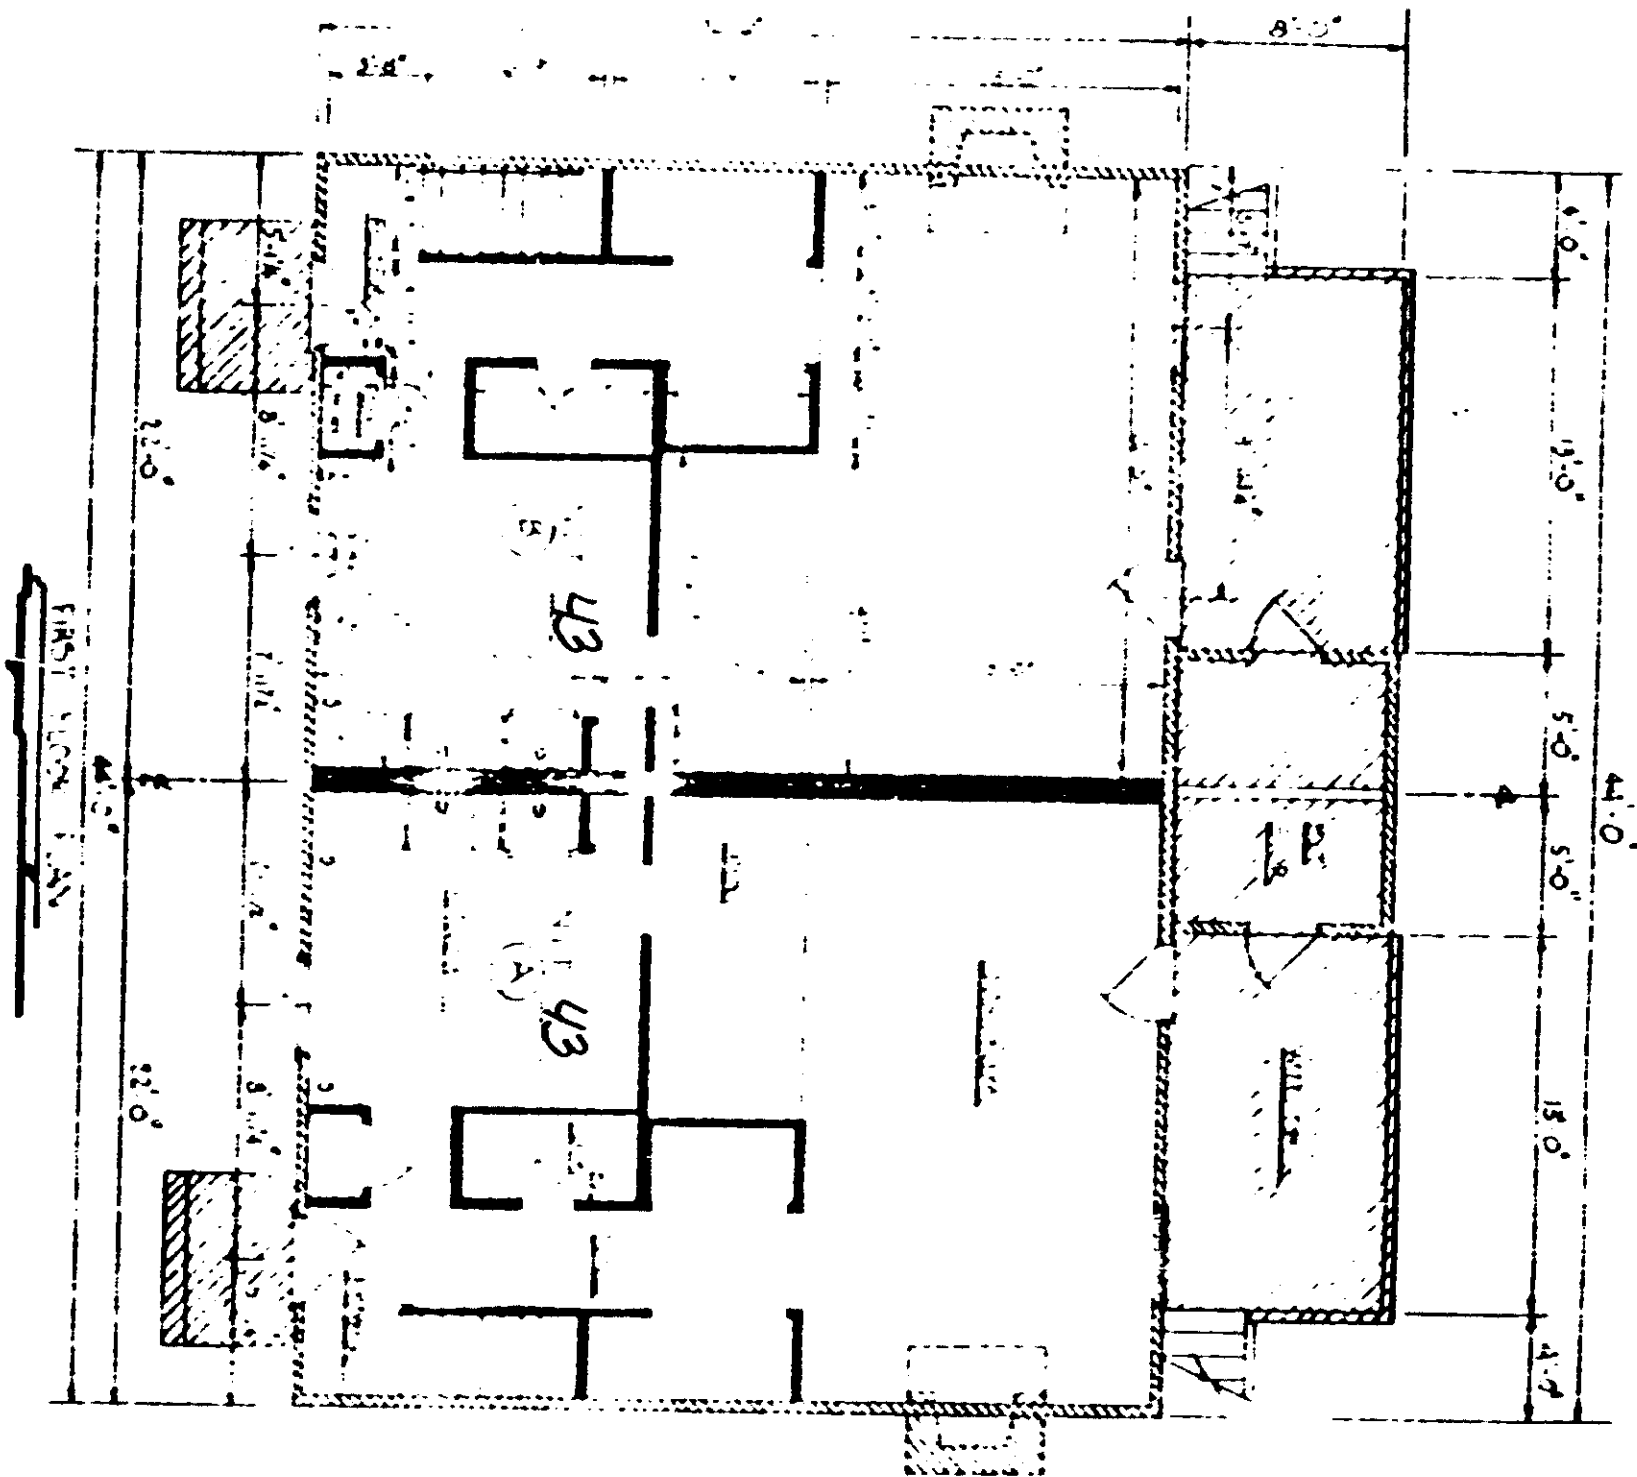

CERTIFICATE

I, Wm. H. Barber, do hereby certify that the above plan fully and correctly shows the construction, location, and dimensions of the building and dwellings contained therein.

Wm. H. Barber



COVER TOXHOUSES No. 43
 HORIZONTAL PROPERTY REGIME

4328 (RV-2)