


ENGINE COMPANY  
Architects

DESIGN SHEET

JOB \_\_\_\_\_  
STRUCTURE \_\_\_\_\_  
LIVE LOAD PER SQUARE FOOT \_\_\_\_\_

JOB NO. \_\_\_\_\_ DATE \_\_\_\_\_  
COMPUTED BY \_\_\_\_\_  
WORKING STRESS \_\_\_\_\_

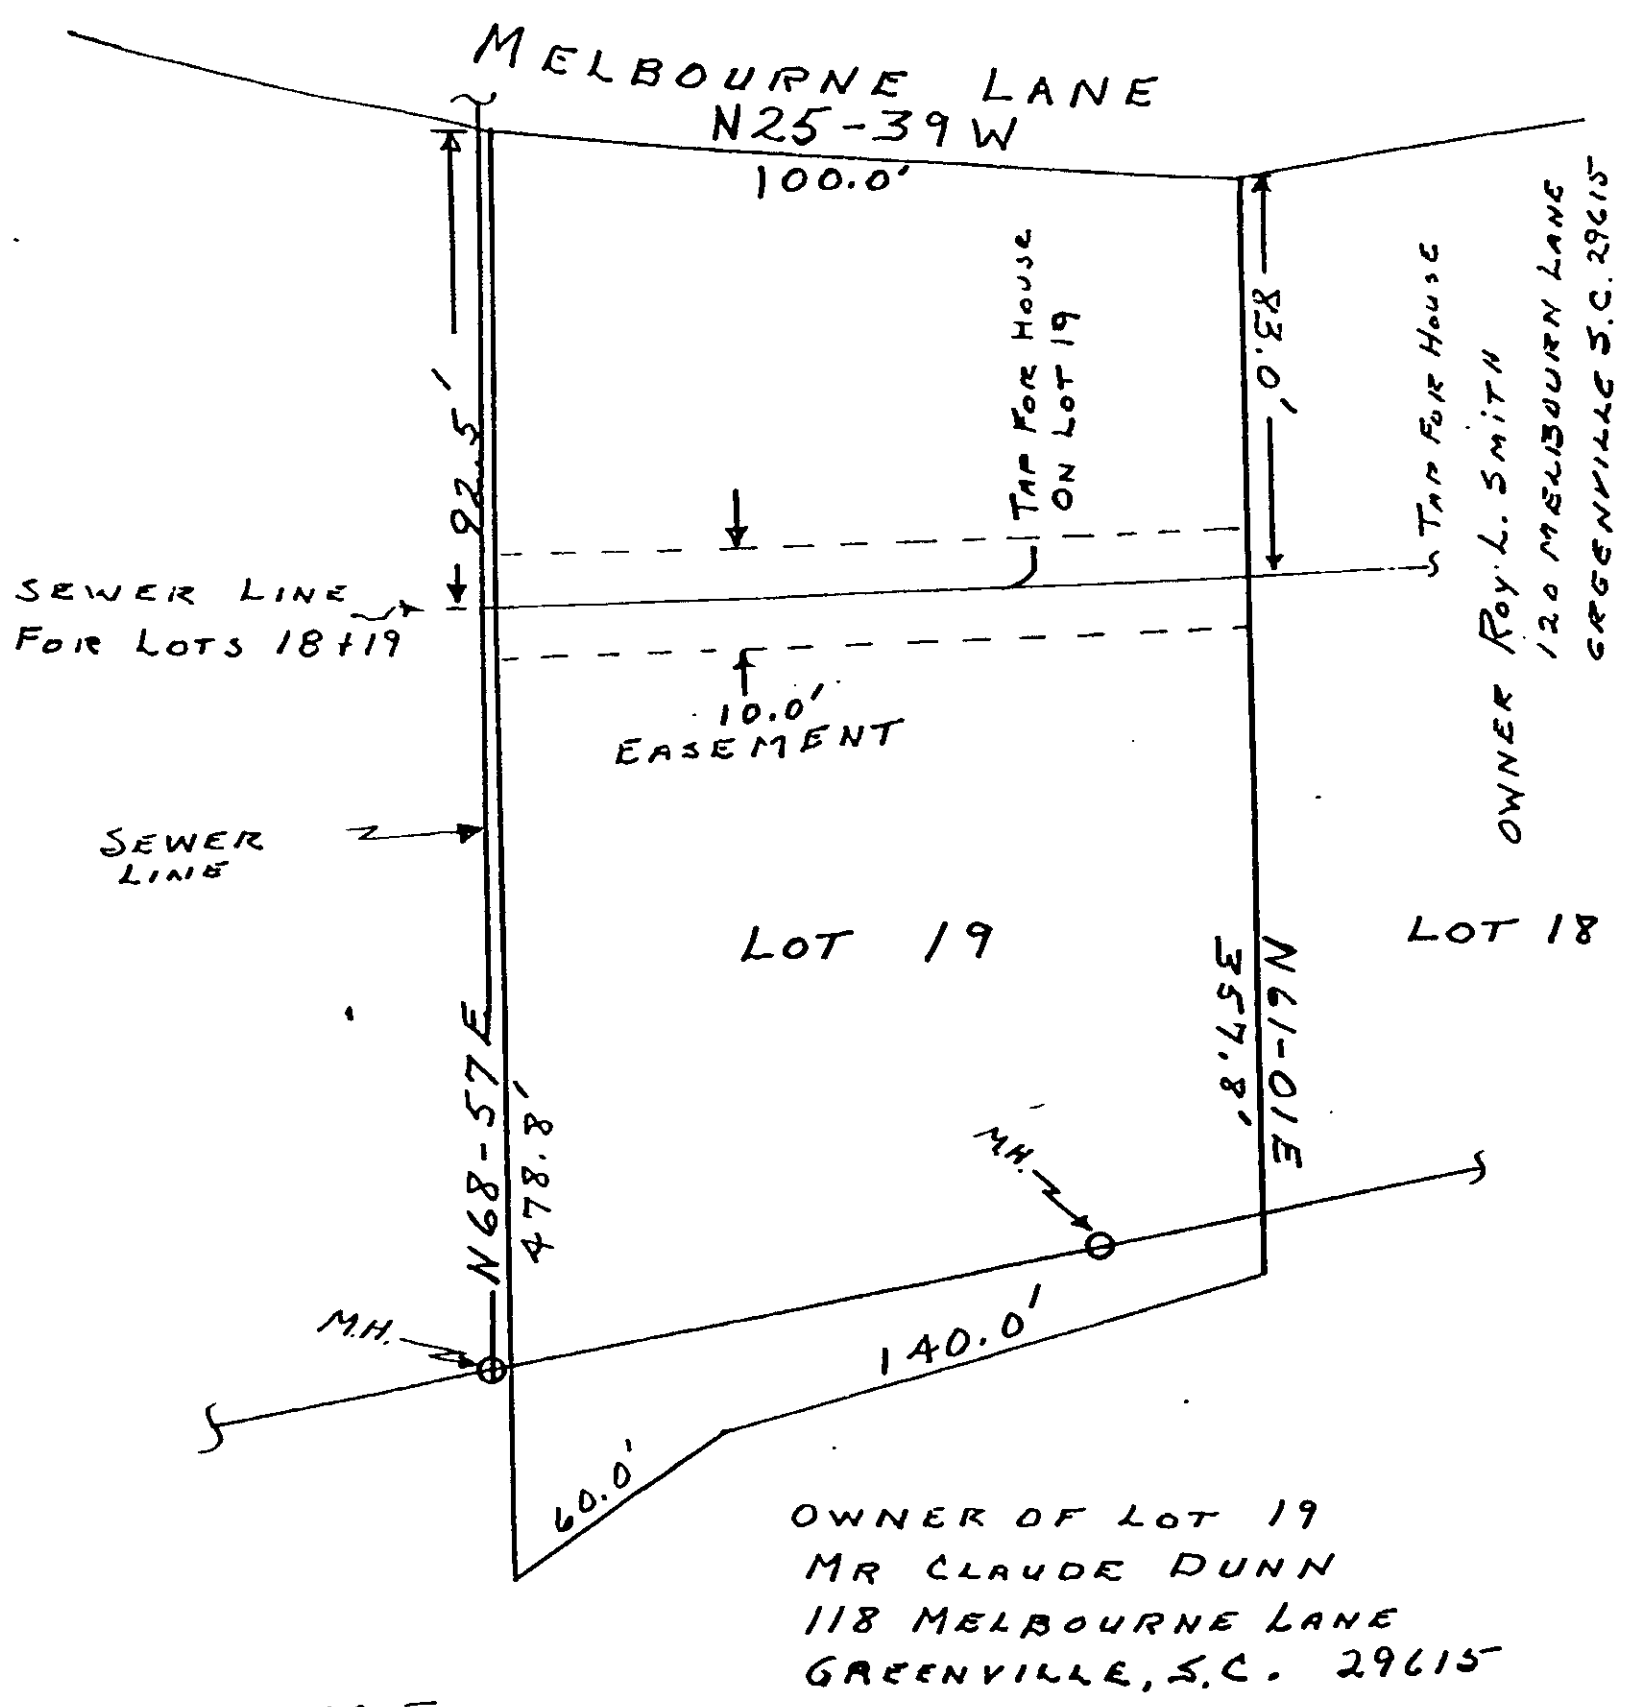

NOT TO SCALE

RECORDED SEP 11 1976 at 3:02 P.M.

7940

4328 RV-2