


Name and Post Office Address of Grantor Mr. Calvin Price
Eastern Business Forms
Haywood Road, Greenville, S. C.

Toll Line or Exchange Line tributary to _____ (Name)
 _____ (Exchange)

The Property is bounded where the line enters and leaves this property by the property of:
H. H. Forrester on the East
 and ACL Railroad on the West
 Authority 843-0040 Classification 945C
 Area South Carolina

Approved _____
 Title District Manager-Engineering

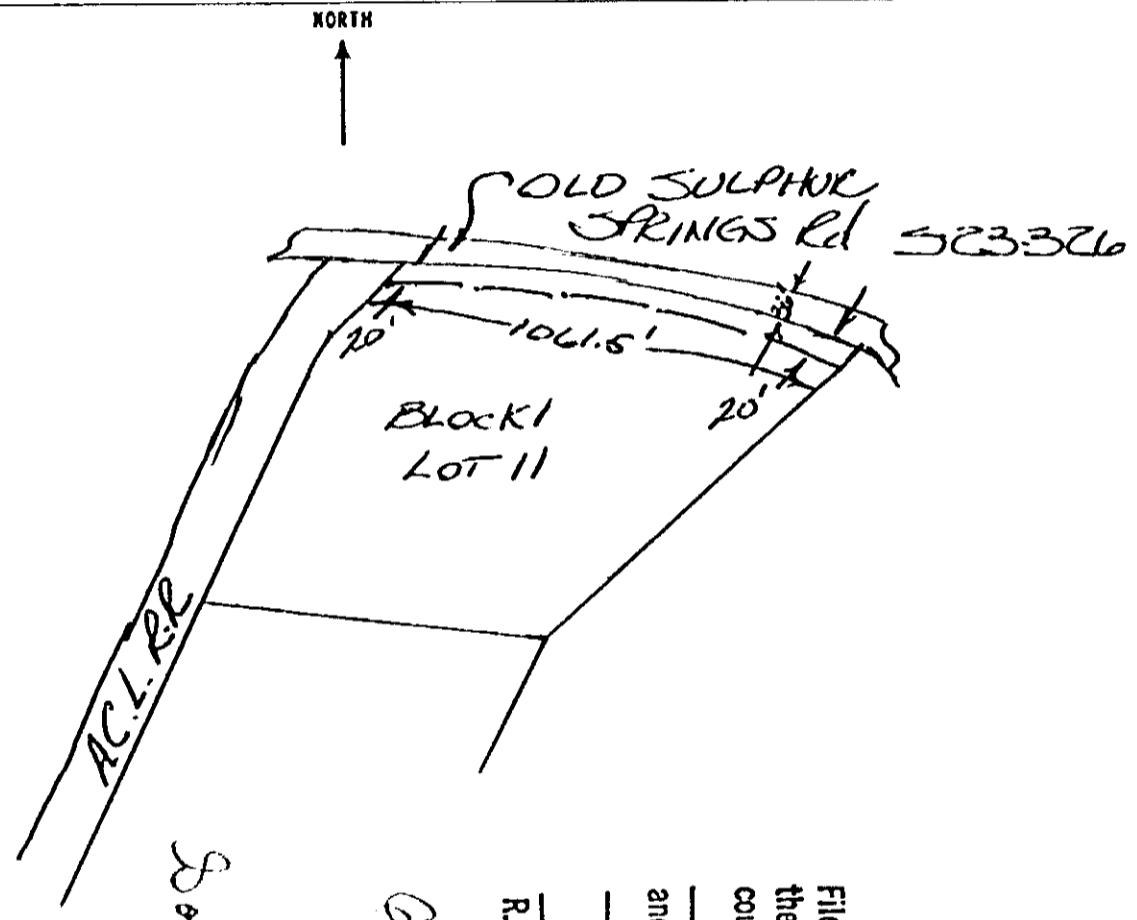

Calvin P. Price
To

R. M. C. for G. Co. S. C.
 Filed for record in the office of
 the R. M. C. for Greenville
 county, S. C. at 10:36 o'clock
 a.m. Dec 13, 1978
 and recorded in Deed Book
 1093 at page 706

Handwritten:
 4x 17915
 DEC 13 1978

RECORDED DEC 13 1978 at 10:36 A.M.

17915

070

4328 RV-2