


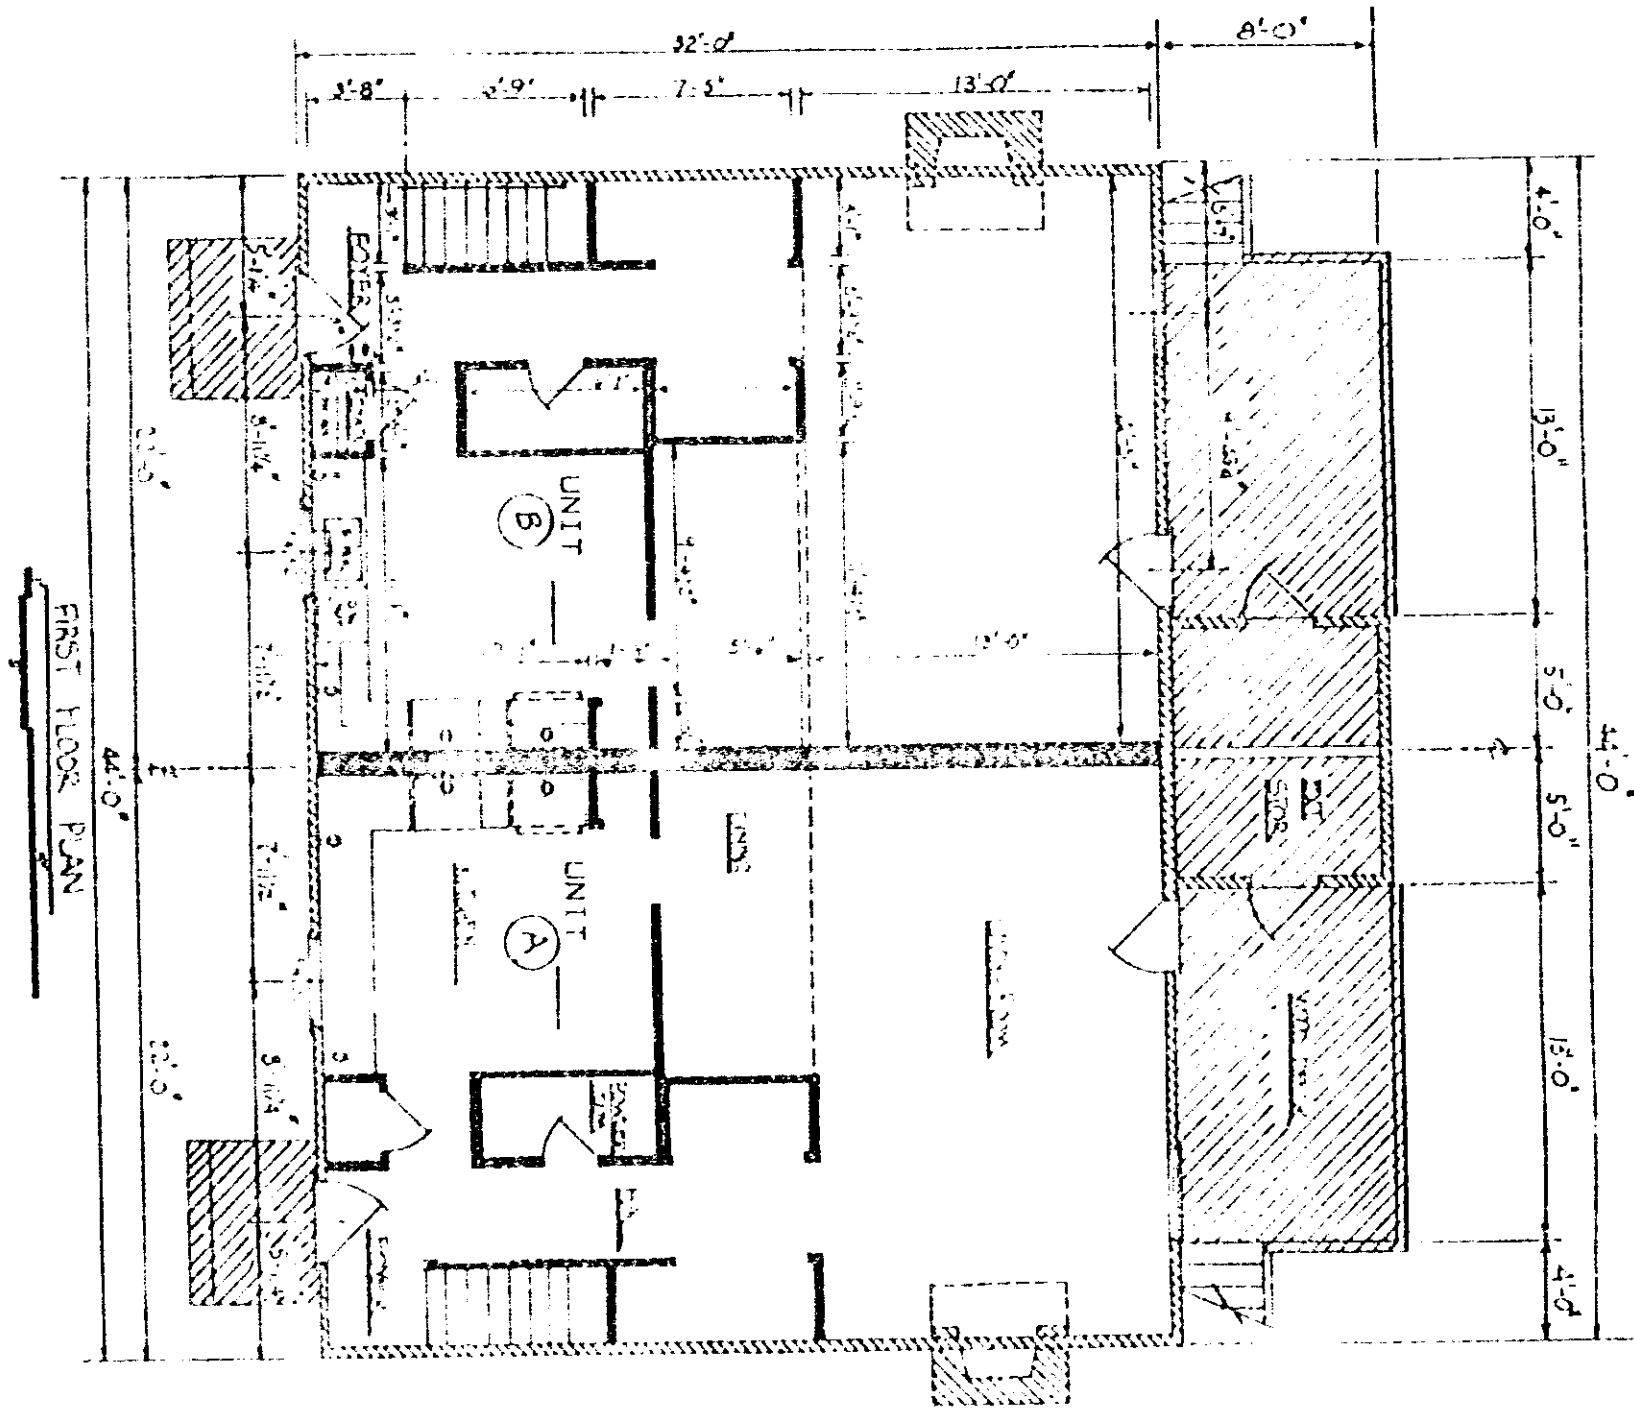

LIMITED COMMON ELEMENTS

VOL 1035 PAGE 233

Exhibit A



CERTIFICATE

I, Wade H. Barber, do hereby certify that these plans fully depict within reasonable construction tolerances the layout, location, letter identification, and dimensions of the buildings and dwellings contained therein.

Wade H. Barber

