


FILED  
GREENVILLE CO. S. C.  
MAY 25 10 19 AM '79  
DONNIE S. TANKERSLEY  
R.H.C.

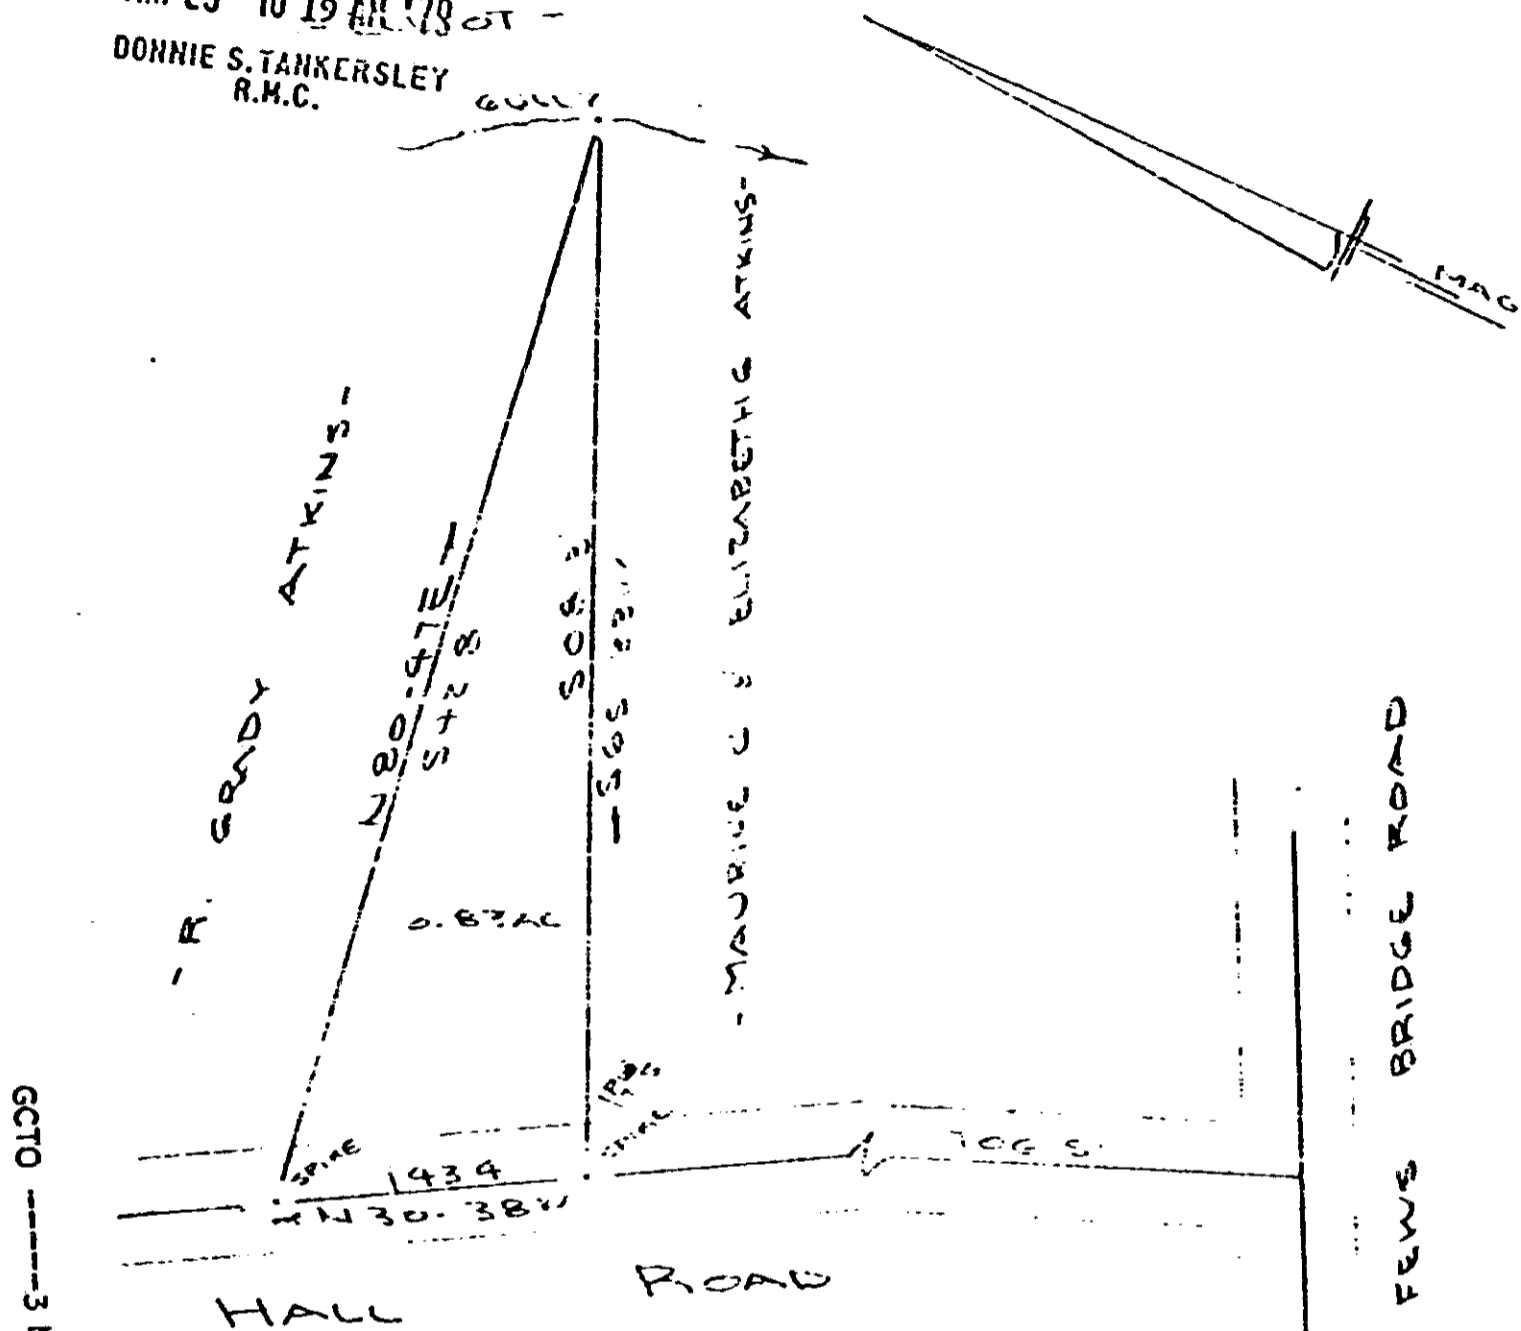

GCTO -----3 MY25 79 810

1.0001

N/B

SURVEY FOR  
MAURICE C ATKINS & ELIZABETH G. ATKINS  
NEAR GREENVILLE SC  
SCALE 1"=100' 2 MAY 1979

7-F-32

CAROLINA SURVEYING CO.  
112 MANLY ST  
GREENVILLE, S.C.

R.B. Brull #1952

492.1 - 1 - PT SO

4163

Recorded August 3, 1979  
at 11:42 A/M

0534

4328 RV-2