

EXHIBIT "B"

VOL 1109 PAGE 291

A. THESE PLANS PERTAIN TO BUILDING 4C

B. THE BUILDING SHOWN IN THIS PLAN CONSISTS OF ONE 2 BEDROOM TOWNHOUSE

EACH UNIT CONSISTS OF THE SPACE BOUNDED BY THE UNDERCOATED AND/OR UNFINISHED SURFACES OF THE PERIMETER, FLOORS, WALLS AND CEILINGS.

UNLESS MARKED ALL INTERIOR AND EXTERIOR ANGLES ARE 90 DEGREES.

C. ARCHITECT'S CERTIFICATE:

I HEREBY CERTIFY THAT, TO THE BEST OF MY KNOWLEDGE, THE INFORMATION SHOWN IS TRUE AND CORRECT.



*Joe V. Hiller*  
JOE V. HILLER, AIA - S.C. REG. NO. 658

D. LEGEND:

BOUNDARY OF UNIT

LIMITED COMMON ELEMENT


INTERIOR LOAD BEARING PARTITION

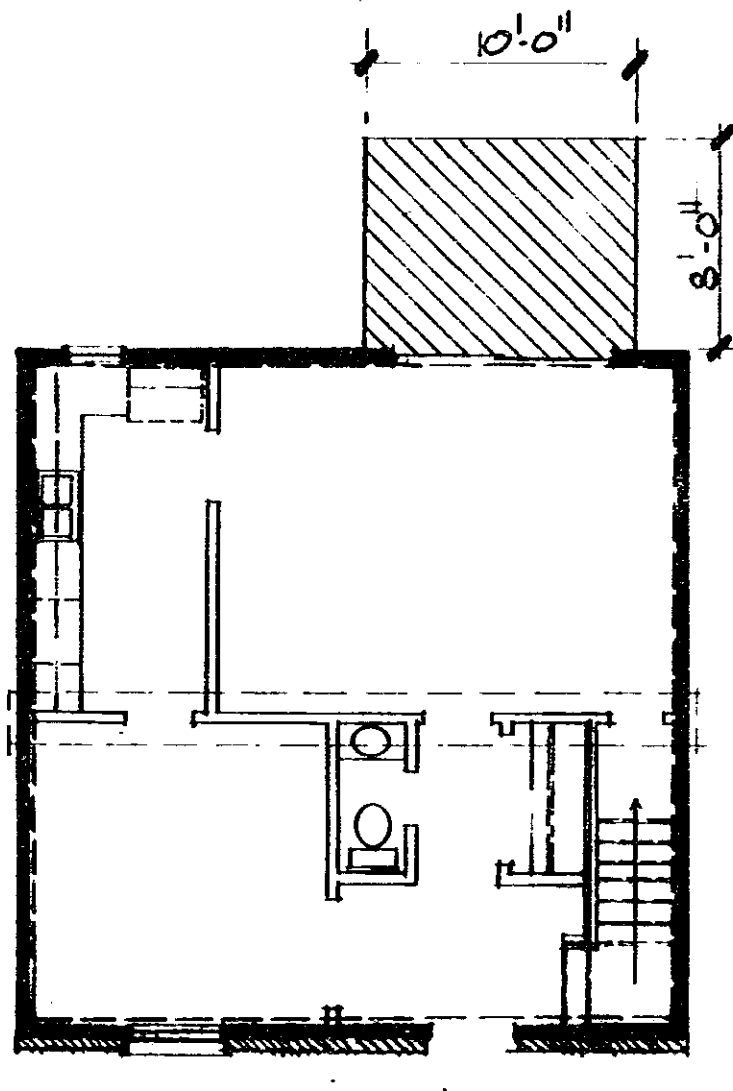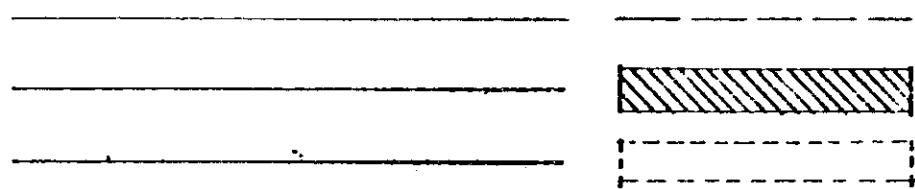

FIRST FLOOR PLAN 6574

1/8" = 1'-0"

'WILLIAMSBURG'

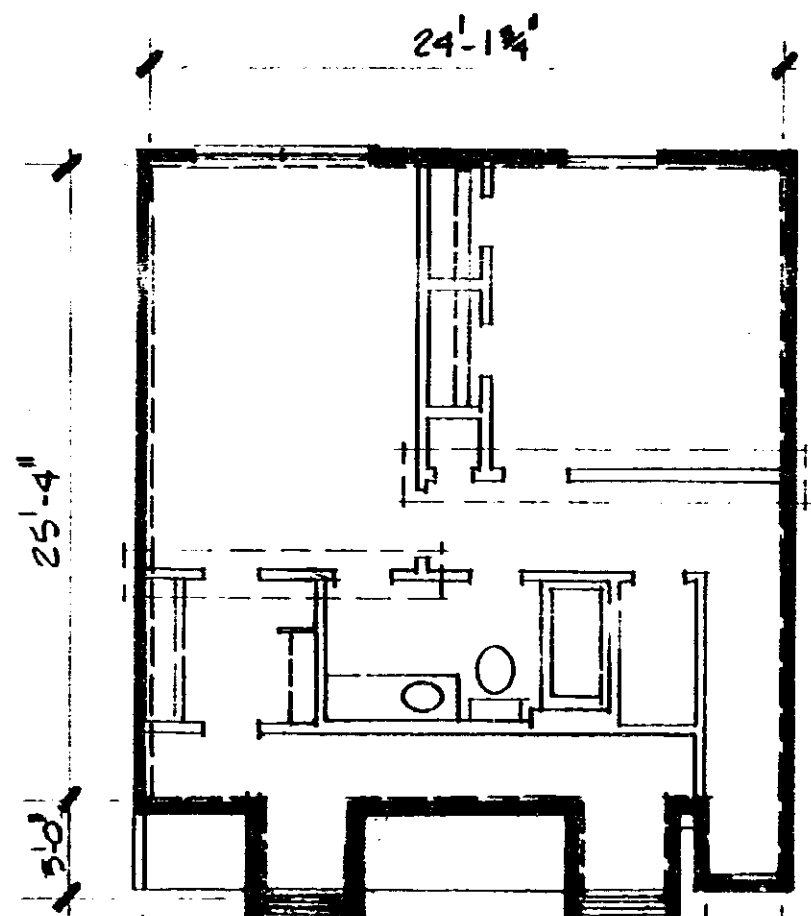

SECOND FLOOR PLAN 5494

1/8" = 1'-0"

0291

4328 RV-2