

Vol 1112 p. 301

Name and  
 Full Mailing Address  
 of Owner: LIDA S ABBOTT  
201 PENNSYLVANIA DR.  
GREENVILLE, S. C. 29609


Toll  
 Line  
 or  
 Exchange Line  
 tributary to: GREENVILLE, SOUTH CAROLINA  
 (Exchange)

The Property is bounded where the line enters and leaves this property by the property of:  
Crestwood Rd. on the NORTHERN SIDE  
 and \_\_\_\_\_ on the \_\_\_\_\_

Authority: C-6538 Classification: 45-C  
GREENVILLE  
 Area: SOUTH CAROLINA

Approved: \_\_\_\_\_  
 Title: \_\_\_\_\_

030

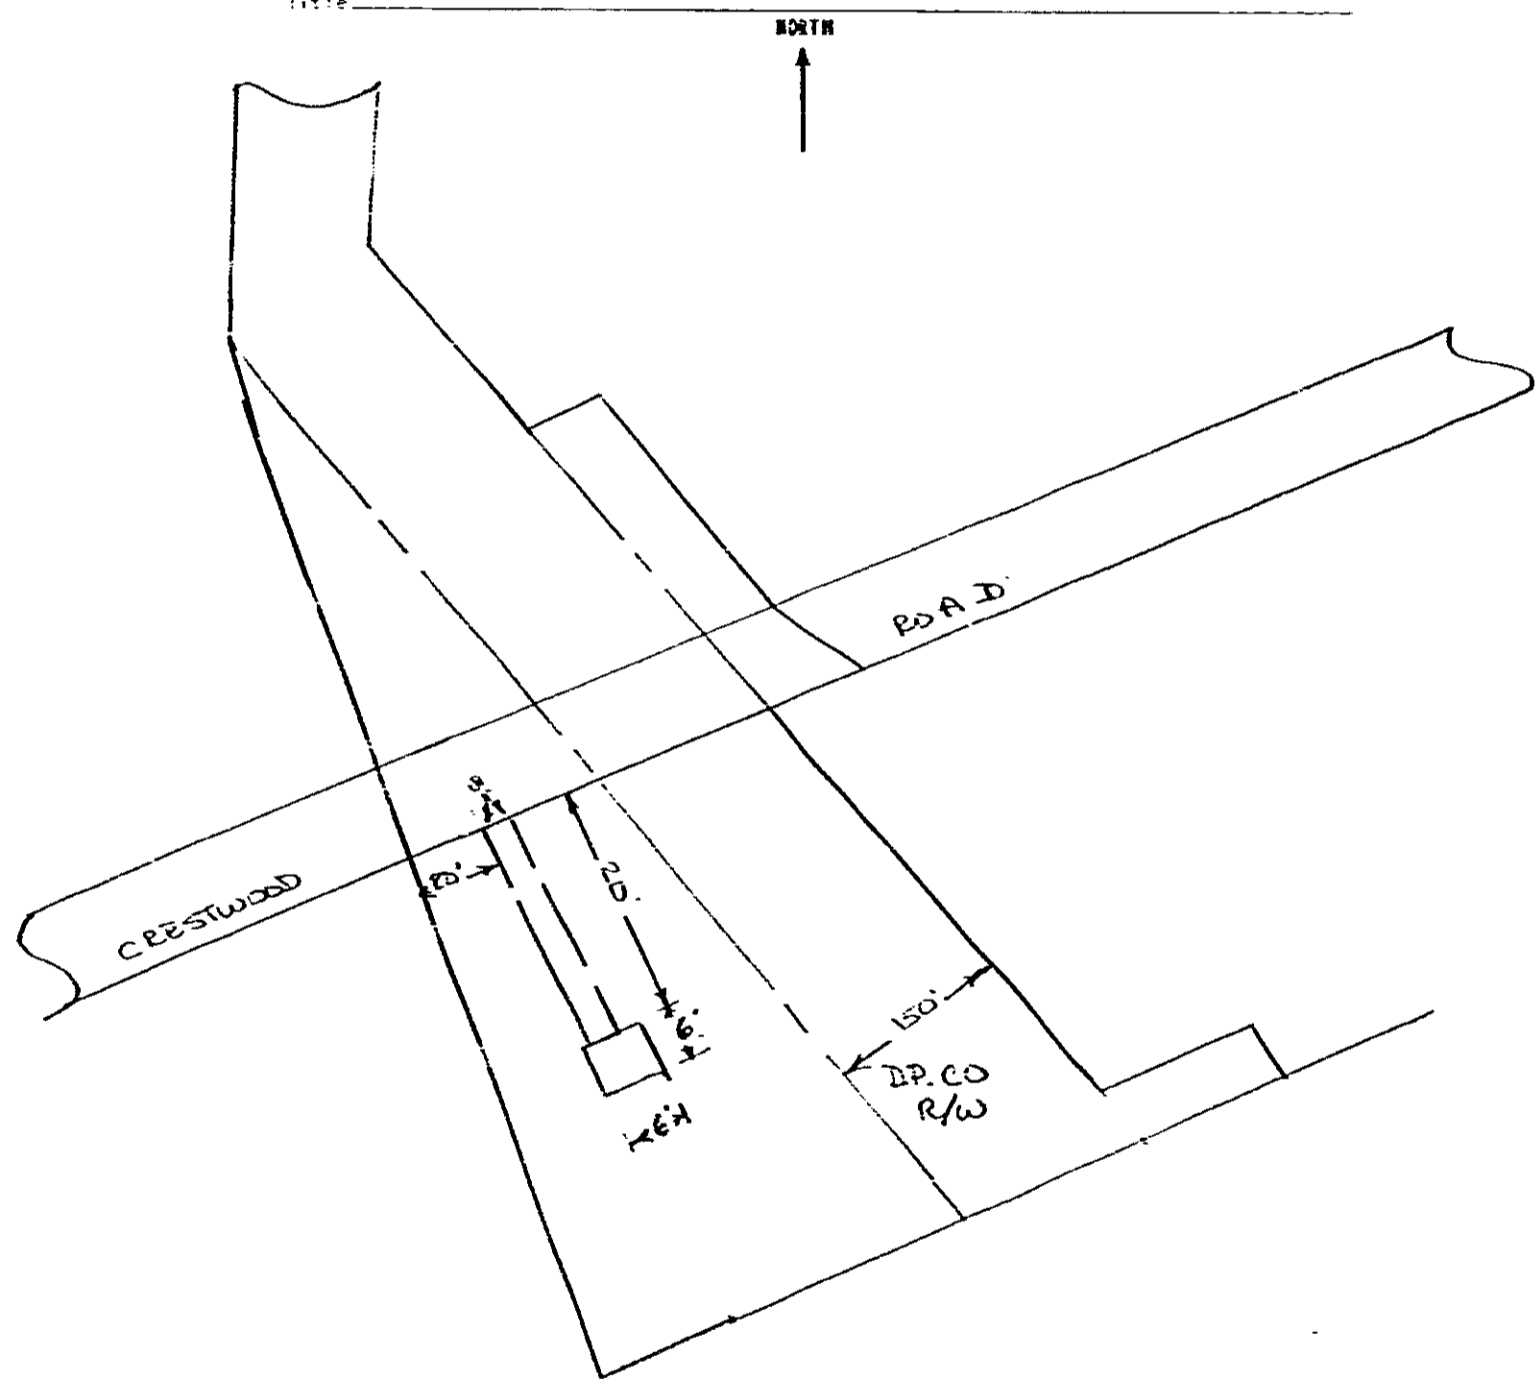

RECORDED SEP 26 1979 at 11:46 A.M.

Filed for record in the office of  
 the R. M. C. for Greenville  
 on Sept. 26, 1979 at 11:46 o'clock  
 and recorded in Deed Book  
 1112 at page 301  
 R. M. C. for G. Co. S. C.

10342

10342

SEP 26 1979

4328 RV-2