
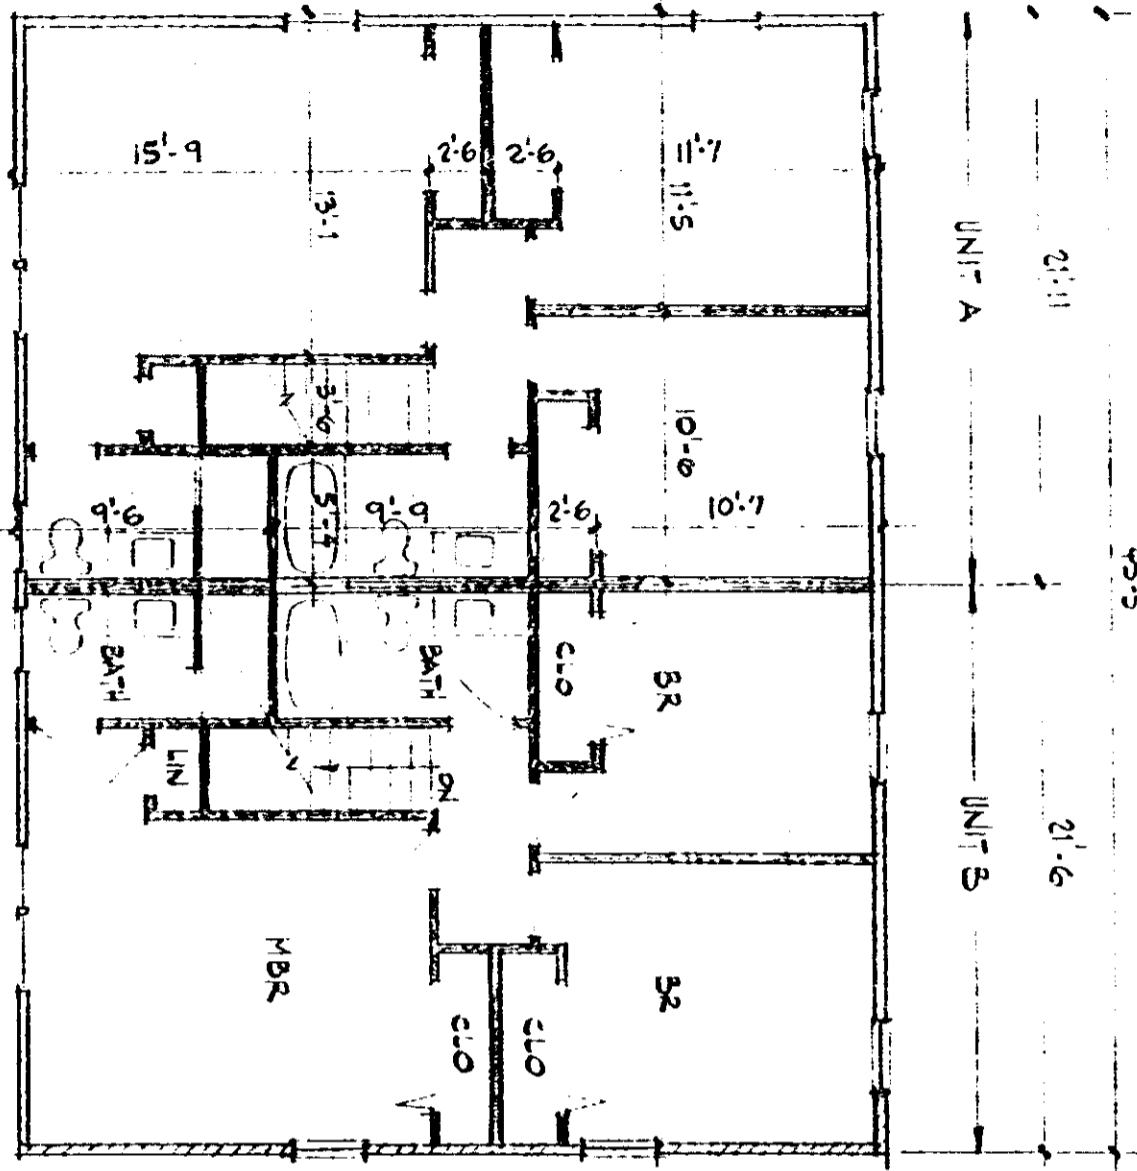


SECOND FLOOR PLAN

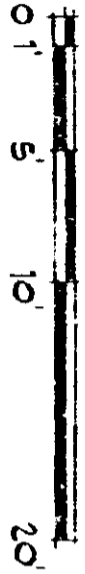

CERTIFICATE

I, Wade H. Barber, do hereby certify that these plans fully depict within reasonable construction tolerances the layout, location letter identification, and dimensions of the buildings and dwellings contained therein.


*Wade H. Barber*

DOVER TOWNHOUSES NUMBER 20

HORIZONTAL PROPERTY REGIME

LIMITED COMMON ELEMENTS

Exhibit A

 

0394

4328 RV-2