


FOUNDATION PLAN
0' 5' 10' 20'

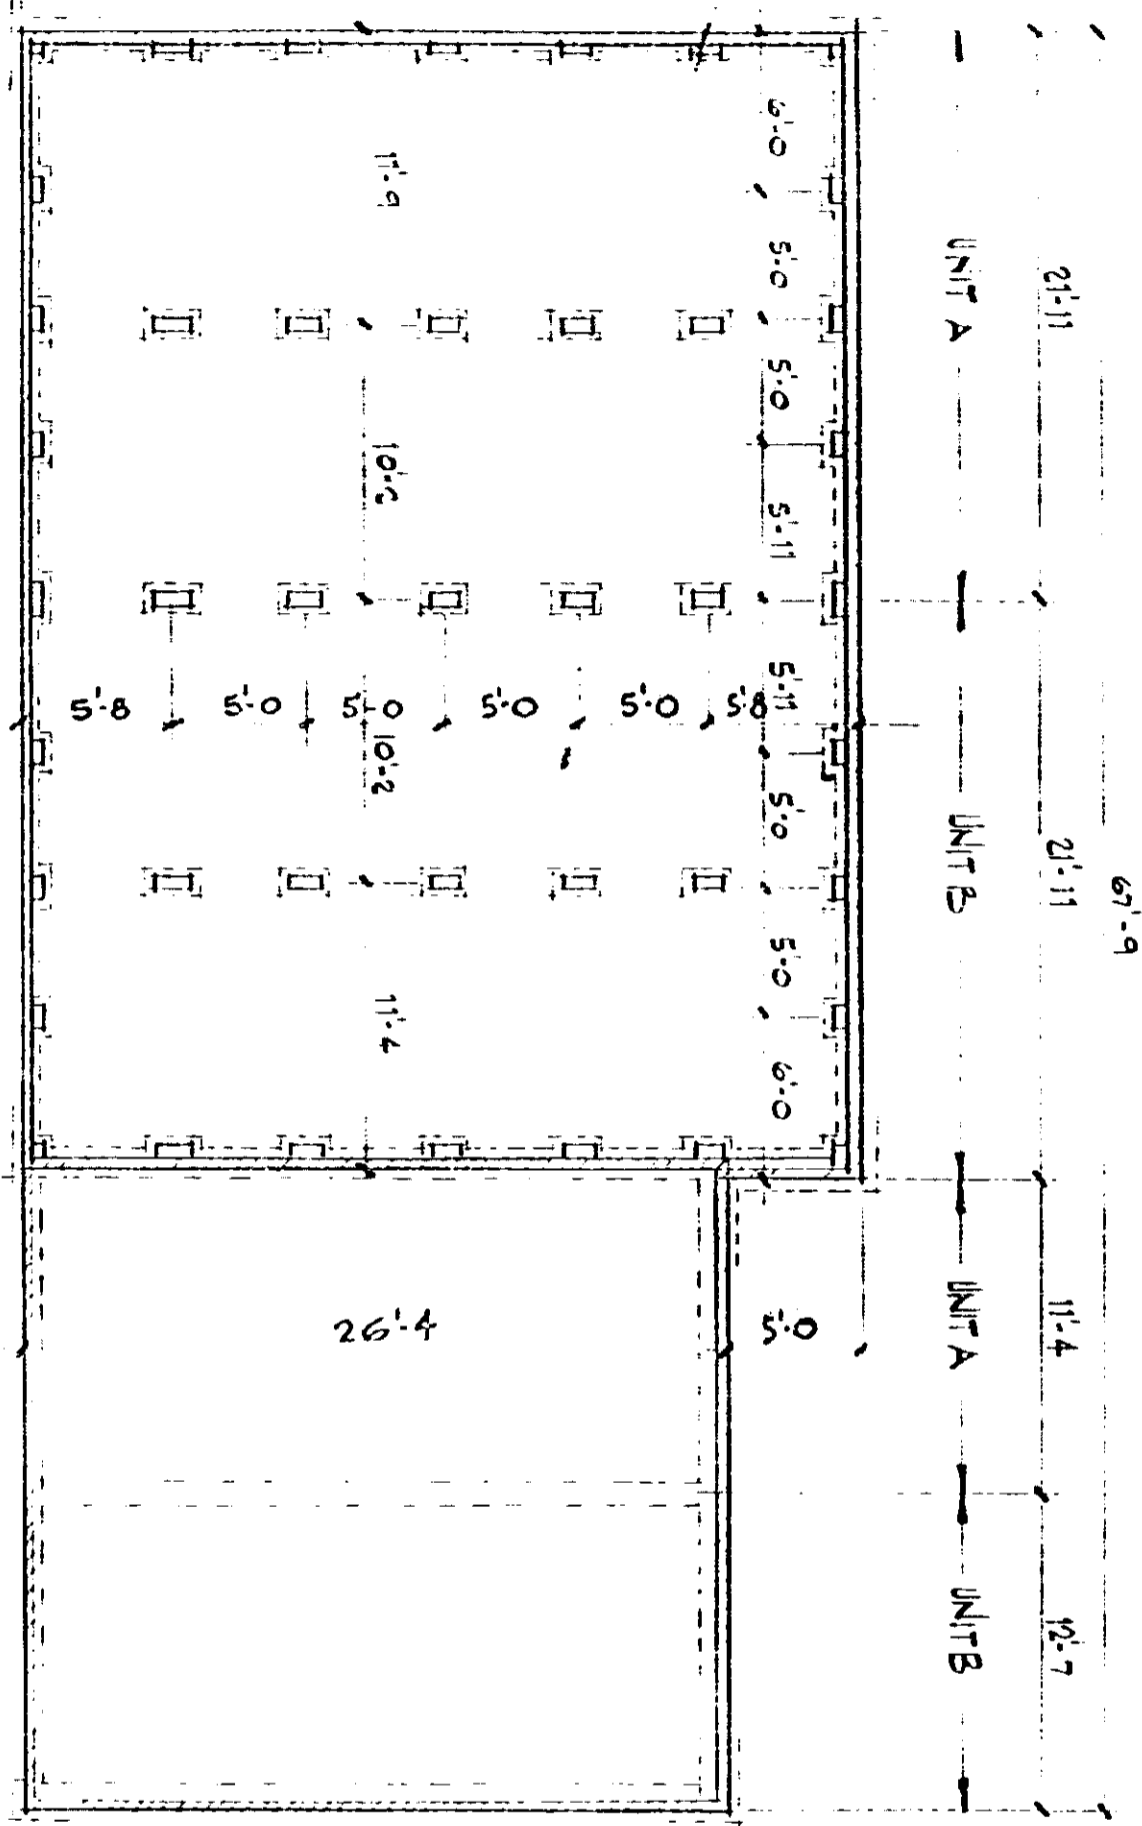

5' 9" 0"

Exhibit A


CERTIFICATE

I, Wade H. Barber, do hereby certify that these plans fully depict within reasonable construction tolerances the layout, location, letter identification, and dimensions of the buildings and dwellings contained therein.

Wade H. Barber

DOVER TOWNHOUSES NUMBER 20

HORIZONTAL PROPERTY REGIME

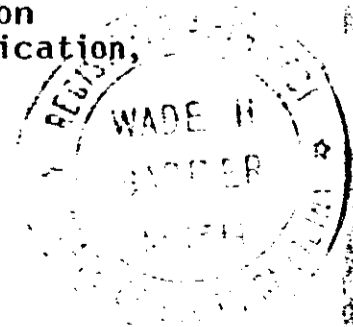

LIMITED COMMON ELEMENTS

4328 RV.2