


EXHIBIT 'A'
MEADE / BAGWELL CONTRACT 2/21/60

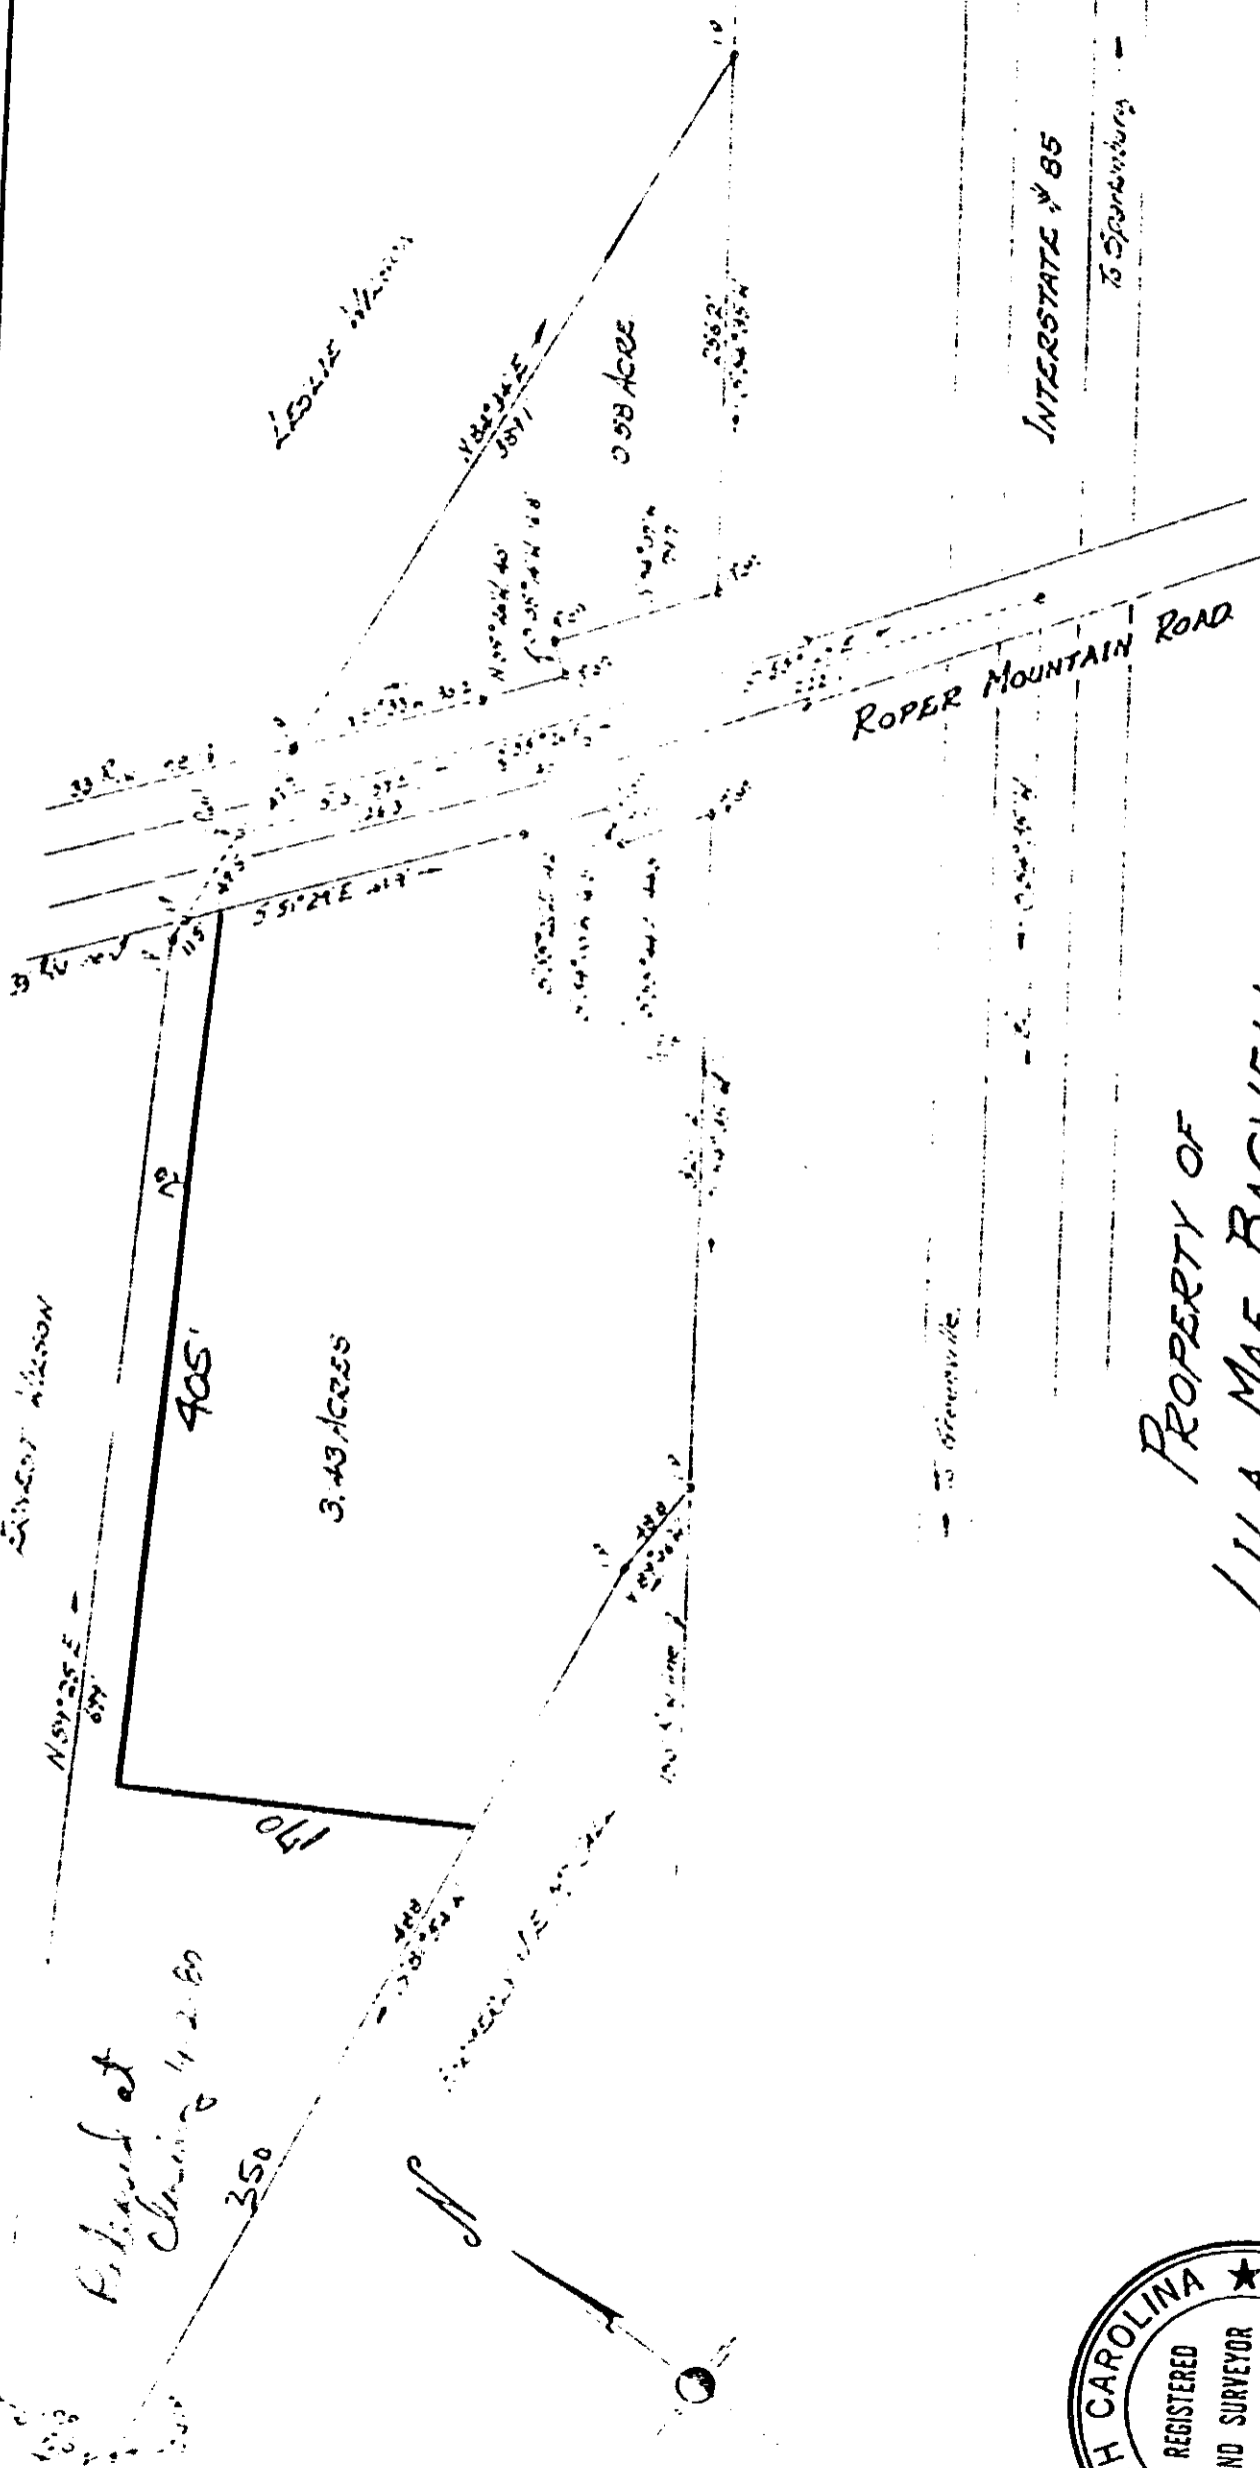

PROPERTY OF
LILA MAE BAGWELL
 located approx 7 miles SE of Greenville
 BUTLER TOWNSHIP GREENVILLE COUNTY
 SOUTH CAROLINA

SCALE 1" = 100 FEET
 Survey made April 22 1968
 MAY 9 1968



Rec: April 10, 1980 at 8:38 AM

29987

072

4328 RV-2