


B 0 4 0

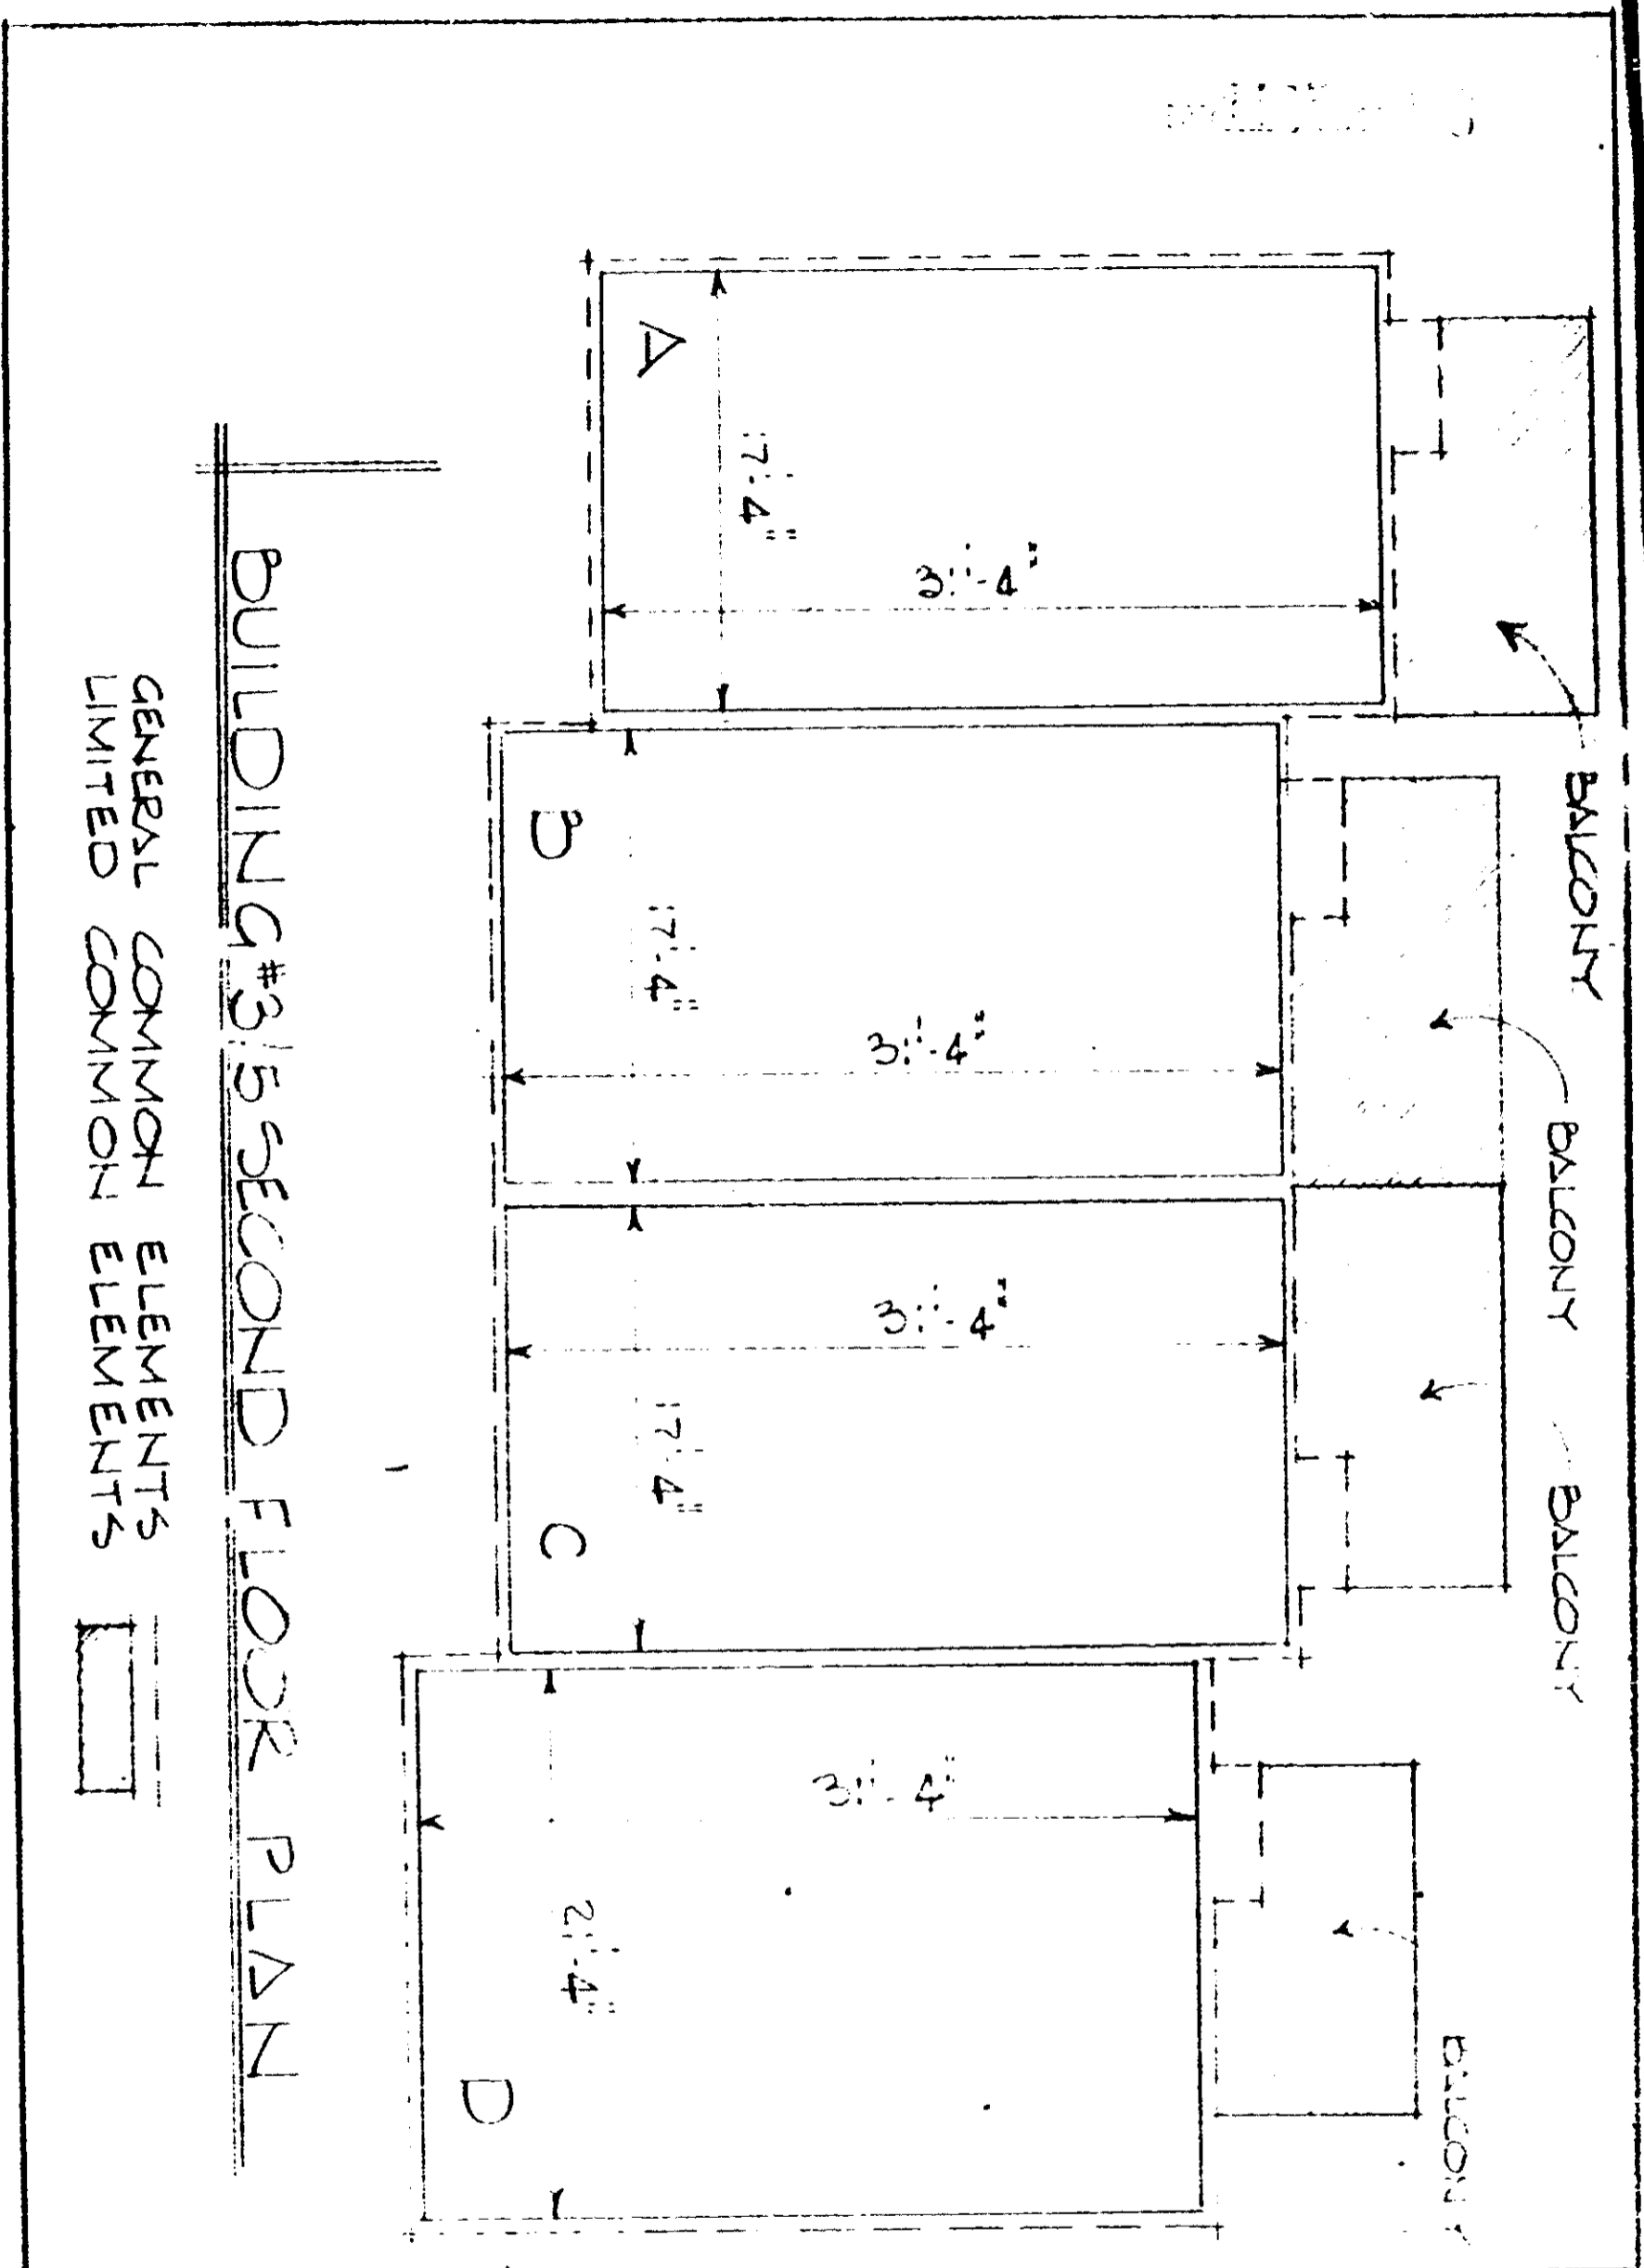


BUILDING #3/5 SECOND FLOOR PLAN

GENERAL COMMON ELEMENTS

LIMITED COMMON ELEMENTS

PEBBLE LAKE HORIZONTAL PROPERTY REGIME

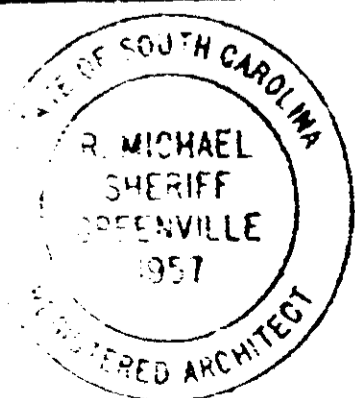

I, R. Michael Sheriff, hereby certify that the within Floor Plans are true and correct to the best of my knowledge.

R. Michael Sheriff 4/8/80

R. Michael Sheriff, AIA  
South Carolina Registered Architect No. 1957

Exhibit B

41

4328 RV-2