



1125-415

ELEVATION BUILDING # 5

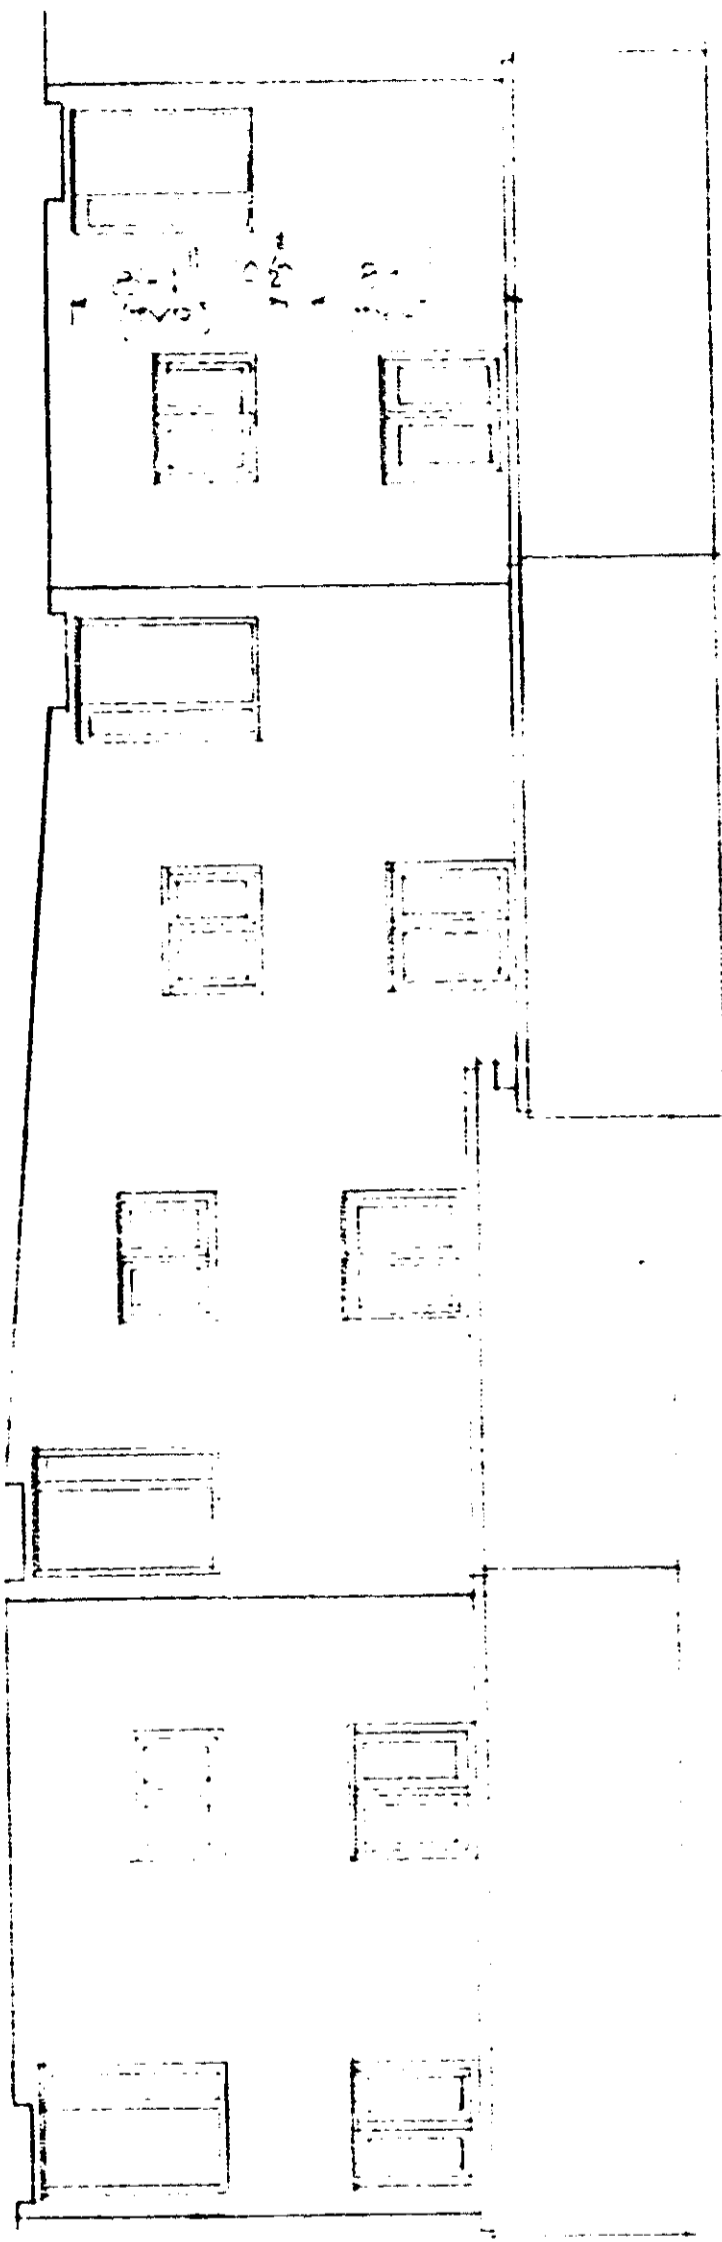

PEBBLE LAKE HORIZONTALS - PROPERTY REGIME

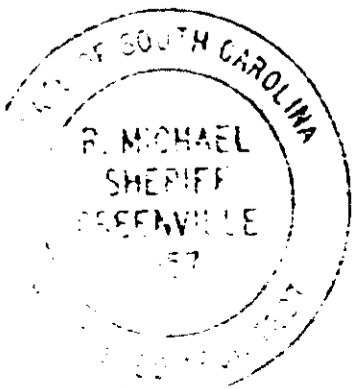

I, R. Michael Sheriff, hereby certify that the within Floor Plans are true and correct to the best of my knowledge.

R. Michael Sheriff
R. Michael Sheriff, AIA
South Carolina Registration No. 1987

EXHIBIT B

42

0415

4328 RV.2