



SECOND FLOOR PLAN

**LEGEND:**

- UNIT BOUNDARY
- - - GENERAL COMMON ELEMENTS
- //// LIMITED COMMON ELEMENTS
- "PORCH" DENOTES COVERED AREA
- "PATIO" DENOTES UNCOVERED AREA
- "CONC." DENOTES CONCRETE SLAB-ON-GRADE CONSTRUCTION
- "WOOD" DENOTES ABOVE-GRADE WOODEN CONSTRUCTION

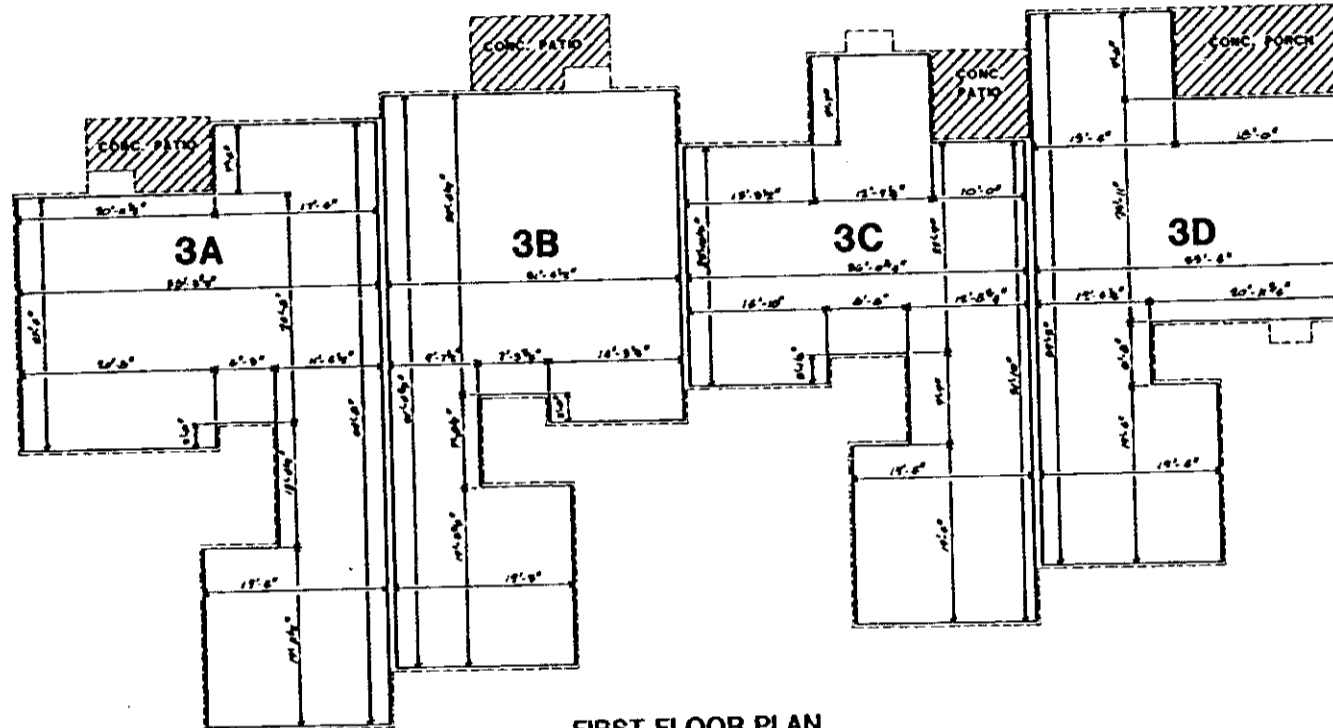

FIRST FLOOR PLAN

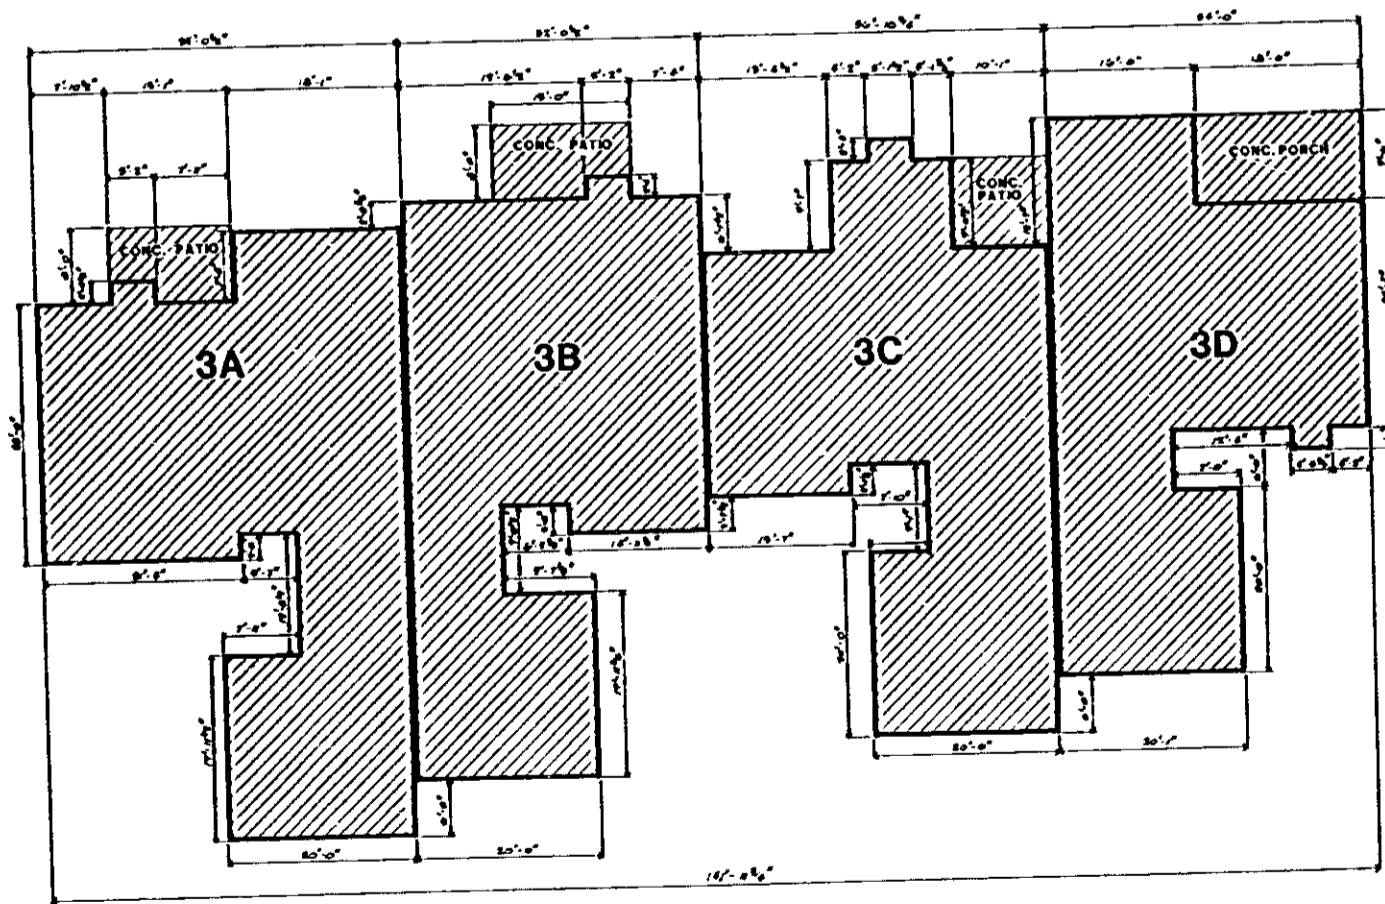


FOUNDATION PLAN

I, ORVILLE V. PLAYER III, HEREBY CERTIFY THAT THE WITHIN FLOOR PLANS ARE TRUE AND CORRECT TO THE BEST OF MY KNOWLEDGE.

*Orville V. Player III*  
 ORVILLE V. PLAYER, III  
 S.C. REGISTRATION # 1595

BUILDING 3

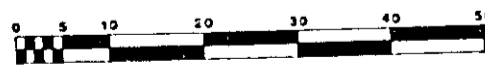


**SUGAR CREEK VILLAS**  
**HORIZONTAL PROPERTY REGIME**

EXHIBIT B SHEET 4

**MILLER/PLAYER & ASSOCIATES**  
 ARCHITECTS AND PLANNERS, LTD.

James D. Miller, A.L.A. / Orville V. Player, III / Robert C. Cashin

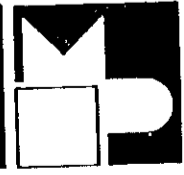

4328 RV-2