



SECOND FLOOR PLAN

LEGEND:

- UNIT BOUNDARY
- - - - GENERAL COMMON ELEMENTS
- //// LIMITED COMMON ELEMENTS
- "PORCH" DENOTES COVERED AREA
- "PATIO" DENOTES UNCOVERED AREA
- "CONC." DENOTES CONCRETE SLAB-ON-GRADE CONSTRUCTION
- "WOOD" DENOTES ABOVE-GRADE WOODEN CONSTRUCTION

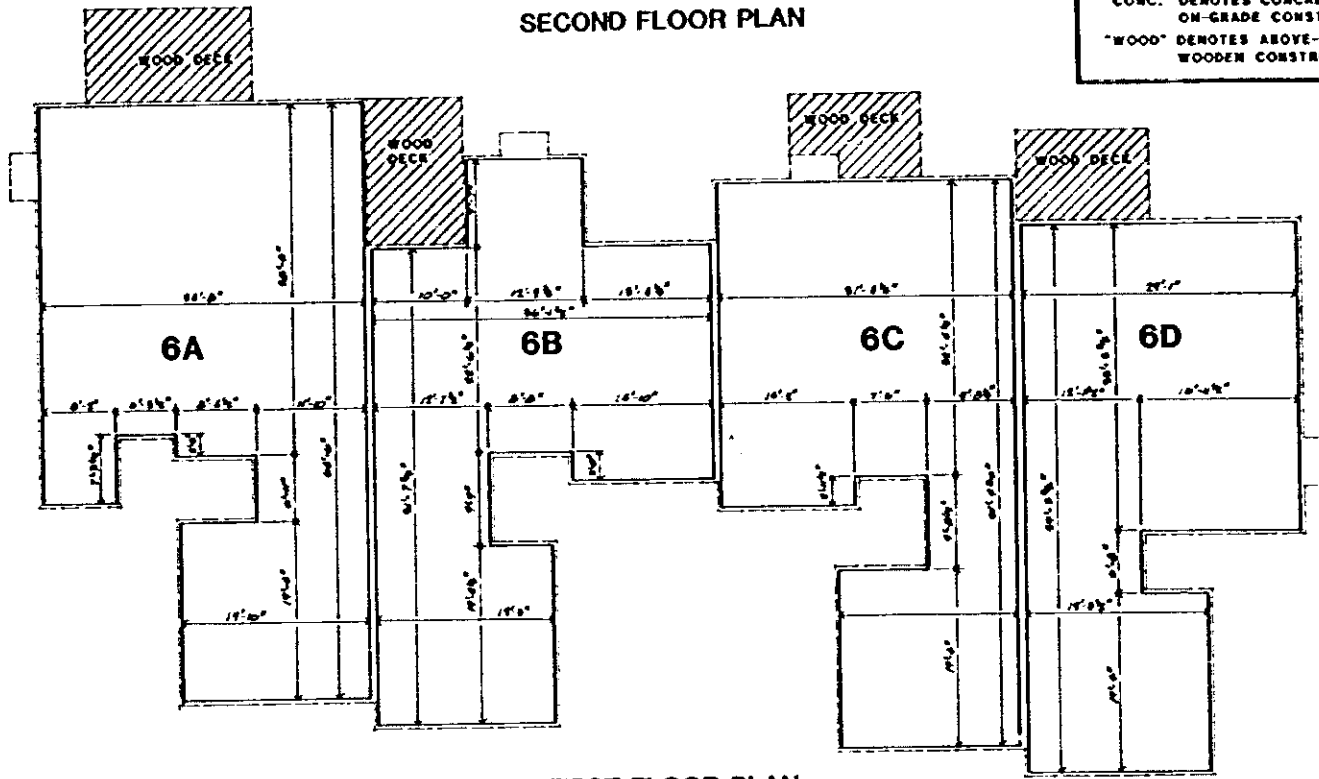

FIRST FLOOR PLAN

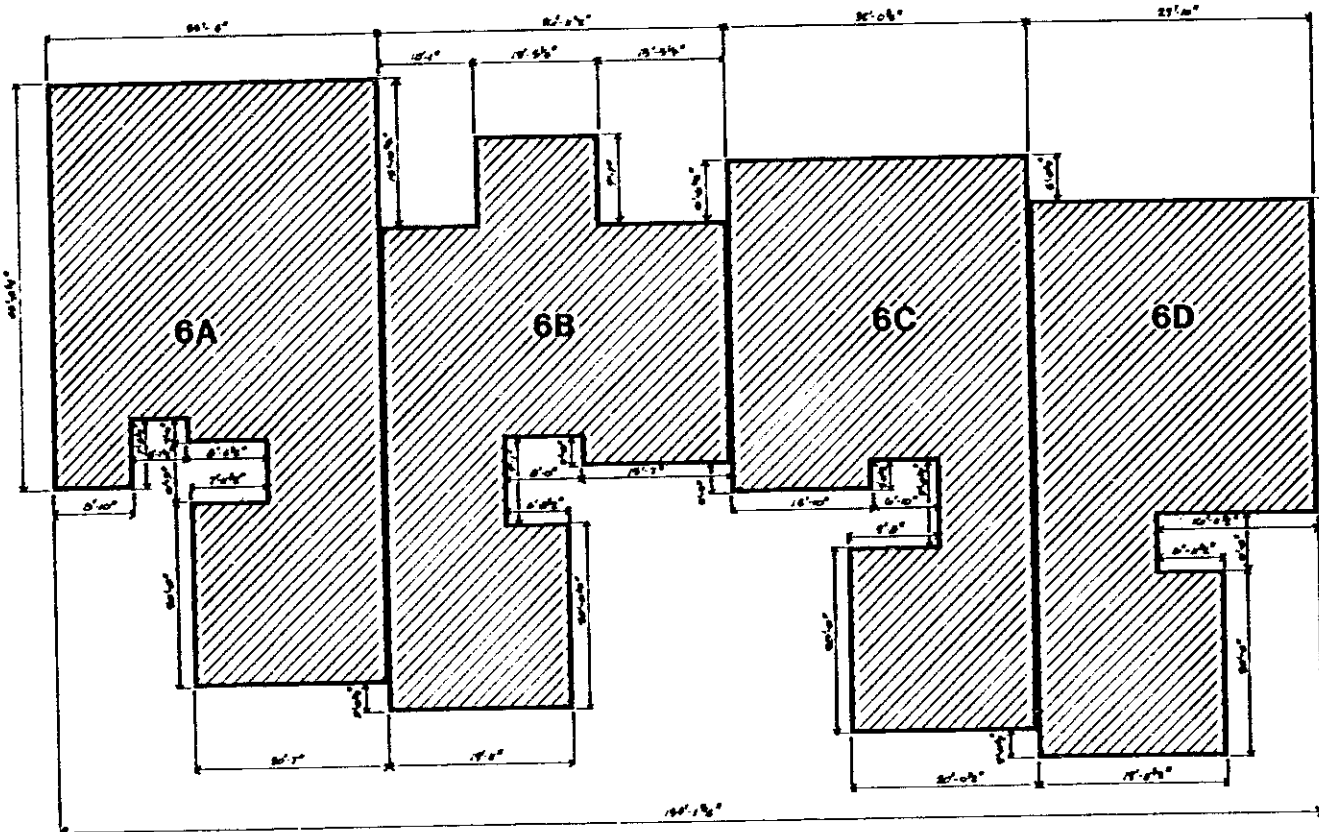

FOUNDATION PLAN

I, ORVILLE V. PLAYER III, HEREBY CERTIFY THAT THE WITHIN FLOOR PLANS ARE TRUE AND CORRECT TO THE BEST OF MY KNOWLEDGE.

Orville V. Player III
ORVILLE V. PLAYER III
S.C. REGISTRATION # 1538

BUILDING 6



**SUGAR CREEK VILLAS
HORIZONTAL PROPERTY REGIME**

EXHIBIT B SHEET 7



**MILLER/PLAYER & ASSOCIATES
ARCHITECTS AND PLANNERS, LTD.**

James D. Miller, A.L.A. / Orville V. Player, III / Robert C. Cochran



4328 RV-2