



**LEGEND:**

- UNIT BOUNDARY
- GENERAL COMMON ELEMENTS
- LIMITED COMMON ELEMENTS
- "PORCH" DENOTES COVERED AREA
- "PATIO" DENOTES UNCOVERED AREA
- "CONC." DENOTES CONCRETE SLAB ON-GRADE CONSTRUCTION
- "WOOD" DENOTES ABOVE-GRADE WOODEN CONSTRUCTION

SECOND FLOOR PLAN

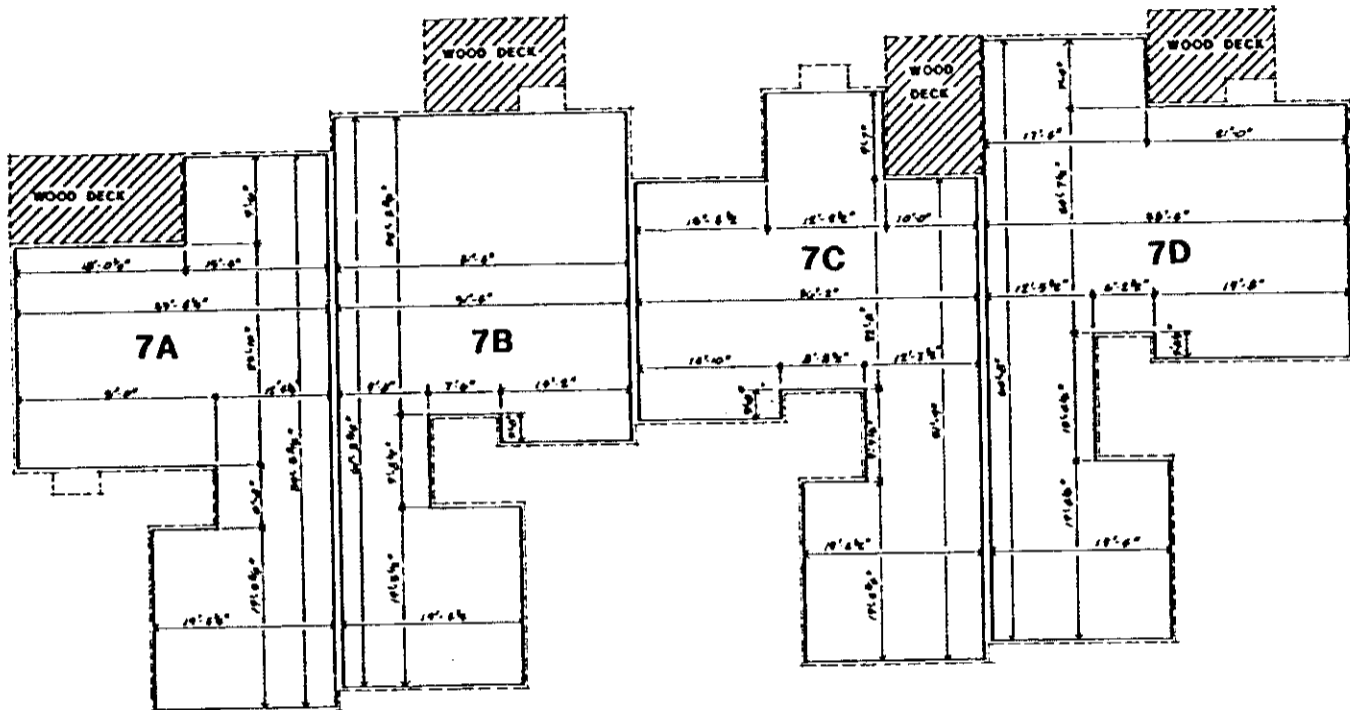

FIRST FLOOR PLAN

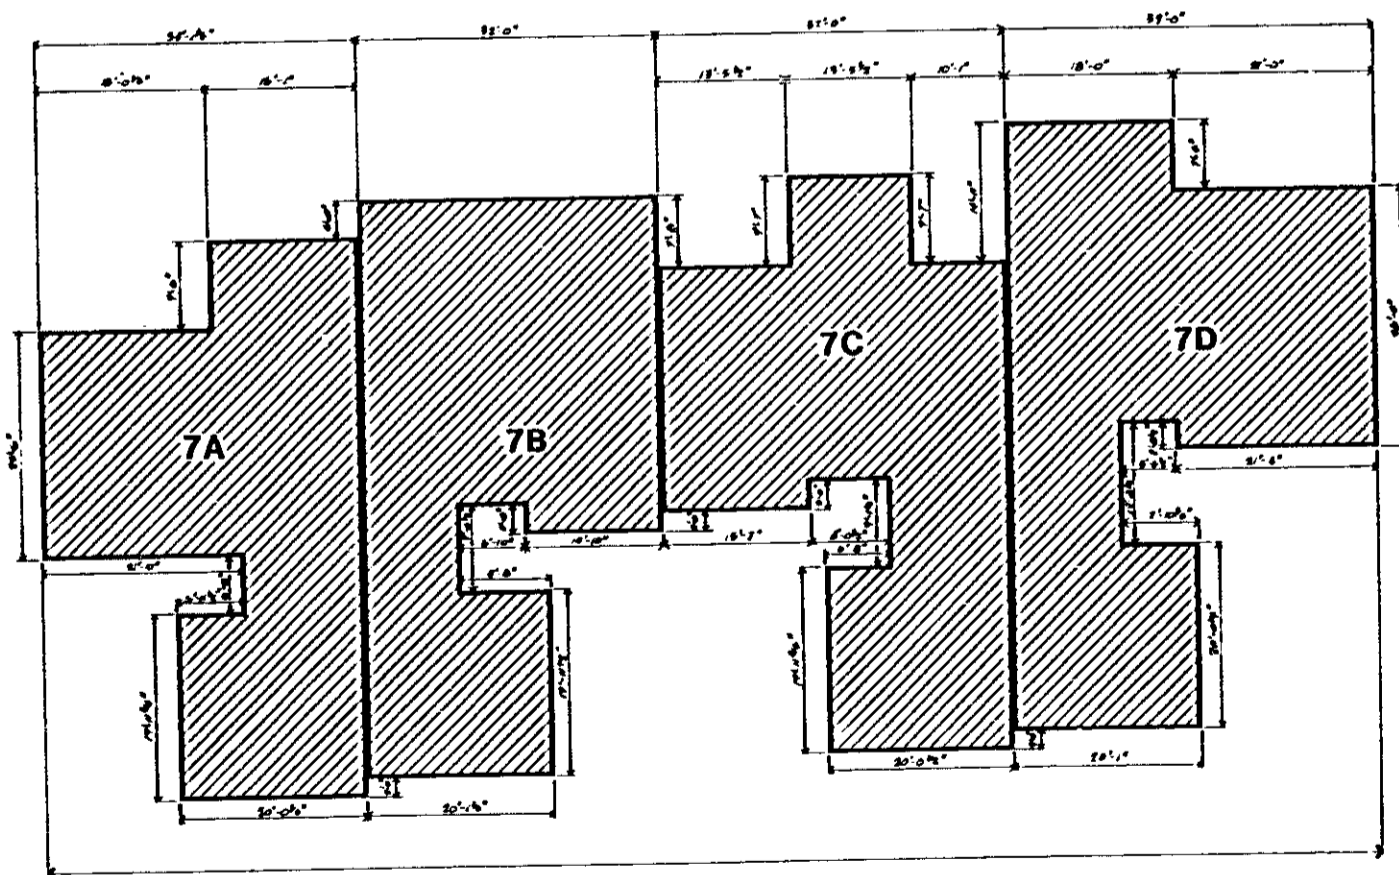

FOUNDATION PLAN

I, ORVILLE V. PLAYER III, HEREBY CERTIFY THAT THE WITHIN FLOOR PLANS ARE TRUE AND CORRECT TO THE BEST OF MY KNOWLEDGE.

*Orville V. Player III*  
ORVILLE V. PLAYER III  
S.C. REGISTRATION # 15598

BUILDING 7



**SUGAR CREEK VILLAS  
HORIZONTAL PROPERTY REGIME**

EXHIBIT B SHEET 8

**MILLER/PLAYER & ASSOCIATES  
ARCHITECTS AND PLANNERS, LTD.**

James D. Miller, A.L.A. / Orville V. Player, III / Robert C. Cadden



4328 RV-2