

I JAMES R. FREELAND  
HEREBY CERTIFY  
THAT THE WITHIN FLOOR  
PLANS ARE TRUE  
AND CORRECT.  
SEDFIELD VILLAS  
HORIZONTAL PROPERTY  
REGIME  
UNIT 30  
*James R. Freeland*

AREA PER RESIDENCE  
(SQUARE FEET)  
1ST LEVEL 553.94  
2ND LEVEL 630.94  
TOTAL 1184.38

FREELAND & ASSOCIATES  
Engineers - Land Surveyors



GREENVILLE, S. C.

DATE FEB. 22. 80

SCALE 1/8" = 1'

SHEET 12

DWG. NO. 4755-16

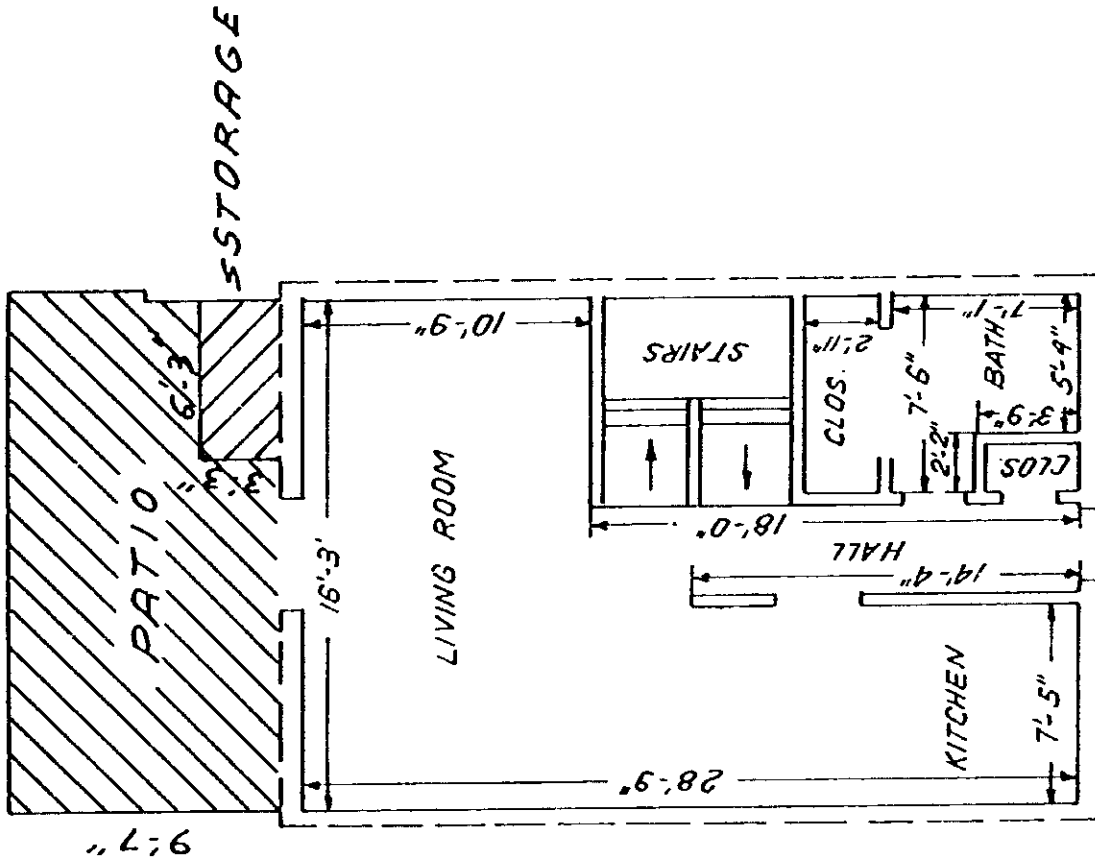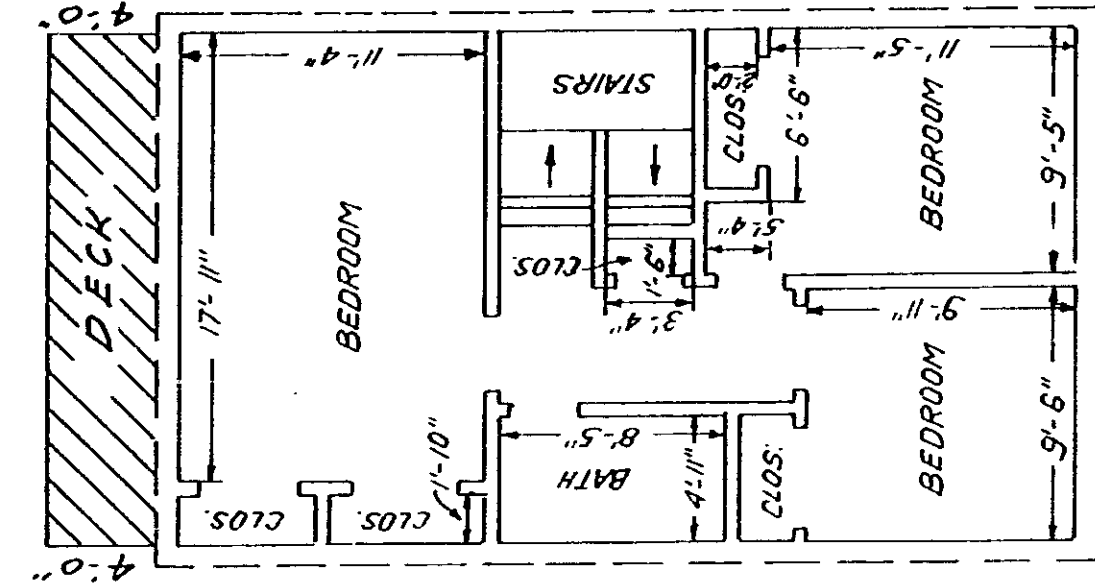

FLOOR PLAN FOR THREE BEDROOM  
SEDFIELD VILLAS  
HORIZONTAL PROPERTY REGIME

- LEGEND
- UNIT BOUNDARY
  - COMMON ELEMENTS
  - ▨ LIMITED COMMON ELEMENTS