


Name and Post Office Address of Grantor GEORGE LEE HOOPER
303 ECHO CIRCLE
EASLEY S.C., 29640

Toll Line or Exchange Line tributary to GREENVILLE, SOUTH CAROLINA
(Name) (Exchange)

The Property is bounded where the line enters and leaves this property by the property of:
COLUMBIA AVENUE on the NORTH
and ALAMO STREET on the WEST
Authority C-6985 Classification R45C
Area GREENVILLE, SOUTH CAROLINA

Approved _____
Title _____

NORTH

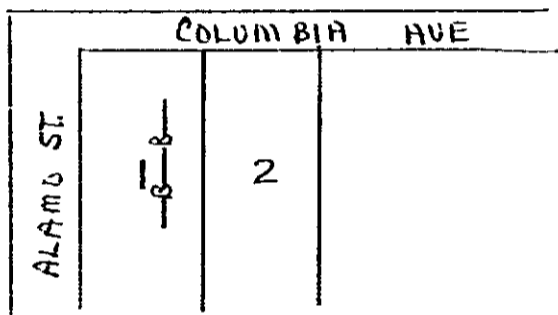

RECORDED OCT 27 1980 at 11:12 A.M.

13082

OCT 27 1980

13082 x

Filed for record in _____ of
the R. M. C. for Greenville
County, S. C. at 11:12 a.m. 1980
A. M. Oct. 27, 1980
and recorded in Deed Book
1136 at page 231
R. M. C. for G. Co. S. C.

2320

4328 RV-2