


1135-905

EXHIBIT "B" (page 2)

5000

4328 RV-2

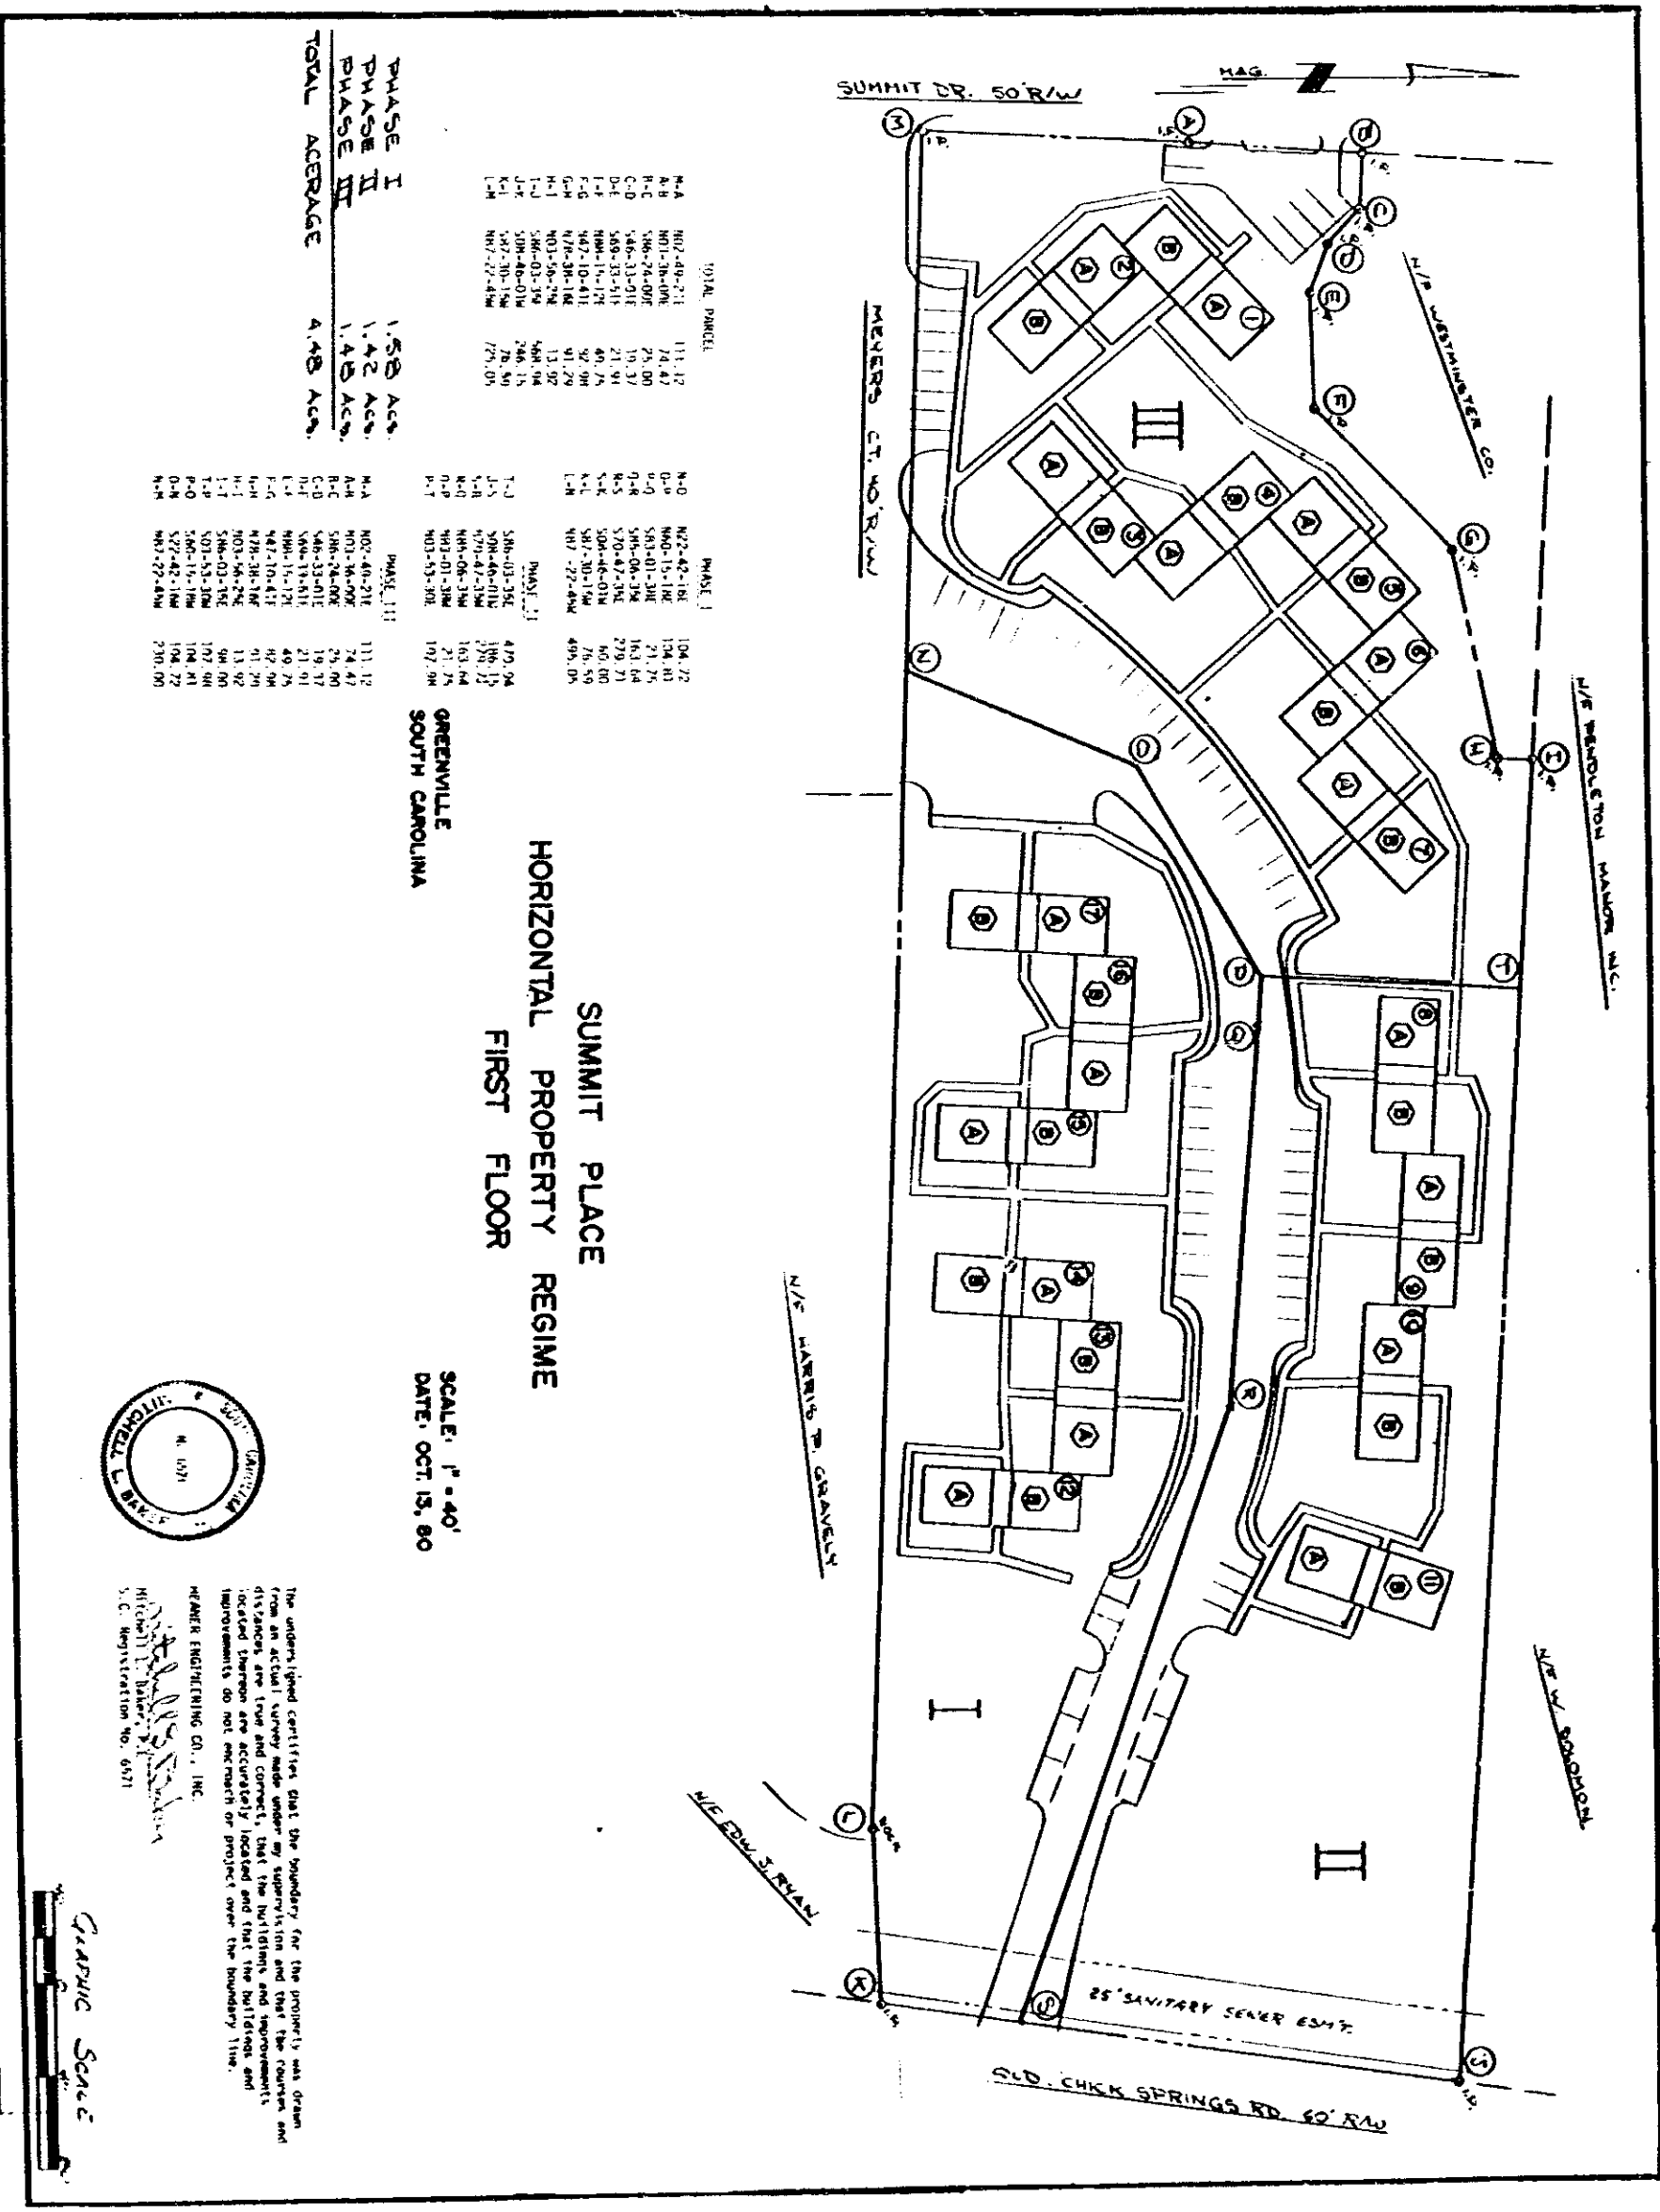


TOTAL PARCELS

N-A	N02-49-271	111.12
N-B	N01-38-096	74.42
N-C	S06-24-007	25.00

PHASE I	1.58 ACS
PHASE II	1.42 ACS
PHASE III	1.40 ACS

PHASE I


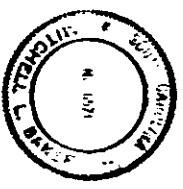

The undersigned certifies that the boundary for the property was drawn from an actual survey made under my supervision and that the courses and distances are true and correct, that the buildings and improvements located thereon are accurately located and that the buildings and improvements do not encroach or project over the boundary line.

MEYER ENGINEERING CO., INC.
S.C. Registration No. 6471

GRAPHIC SCALE