

1138 PAGE 704

Name and Post Office Address of Grantor: PIEDMONT ENGINEERS & ARCHITECTS, INC.
P.O. BOX 1717
GREENVILLE, S.C. 29602.


File No. _____

Toll Line _____ (Charge)
 or Exchange Line GREENVILLE, SOUTH CAROLINA
 tributary to _____ (Exchange)

The Property is bounded where the line enters and leaves this property by the property of:
EAST PARK AVENUE on the NORTH
 and ATLAS STREET on the EAST

Authority P-43514 Classification R45C
 Area GREENVILLE, SOUTH CAROLINA

Approved _____
 Title _____

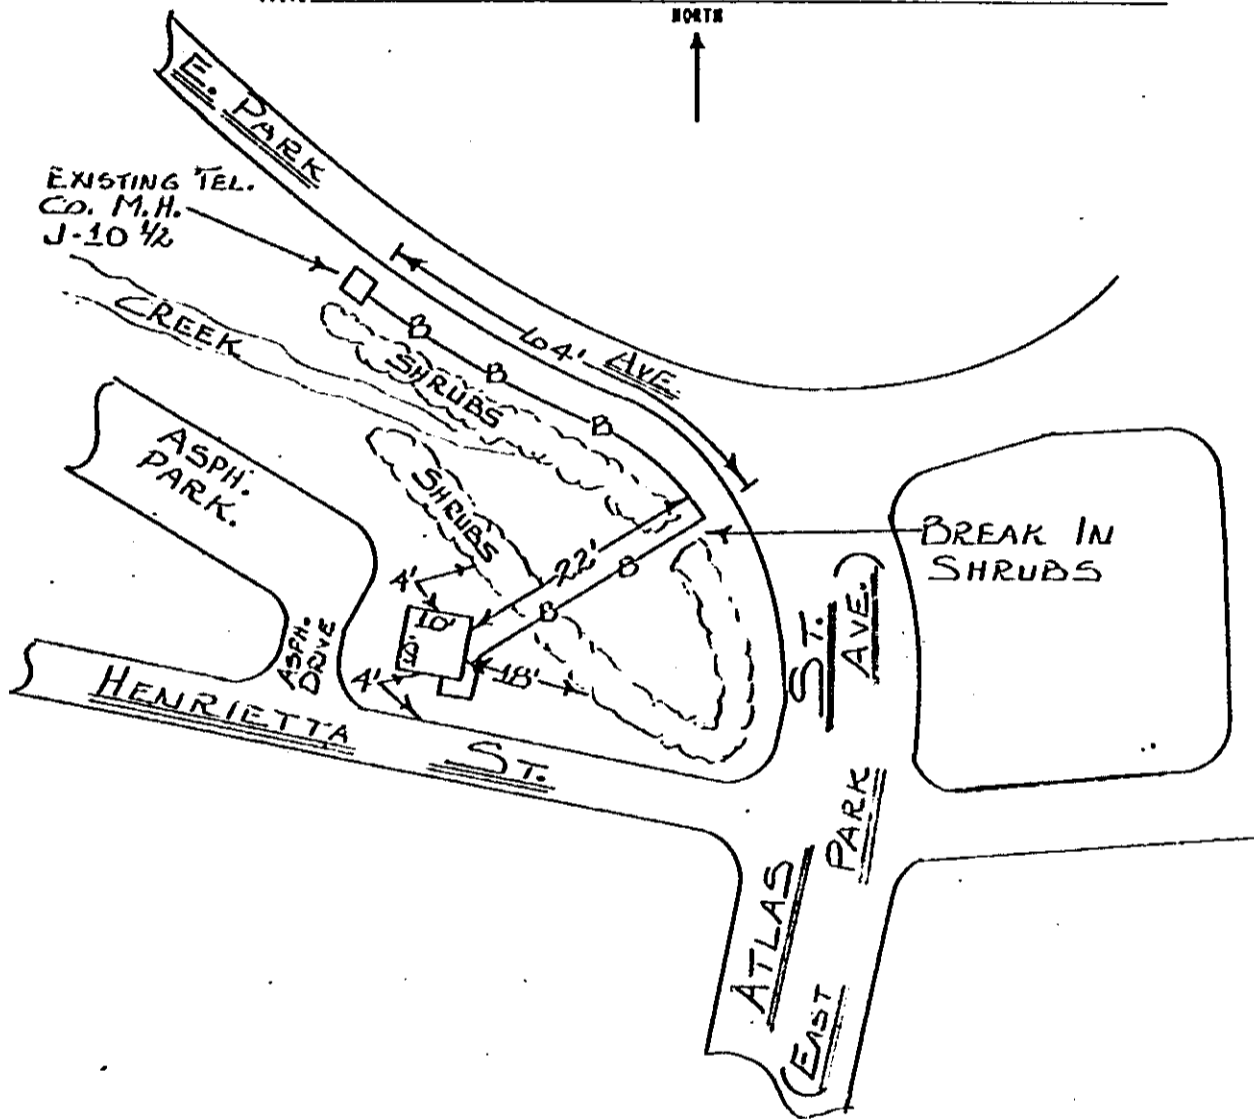

RECORDED: DEC 9 1980 at 10:17 A.M.

17269

x 17269

DEC 9 1980 x

Filed for record in the office of
 the R. M. C. for Greenville
 County, S. C. at 10:17 A.M.
 on Dec. 9, 1980
 and returned in Deed Book
 1138 at page 703.

R. M. C. for G. Co. S. C.

4328 RV-2

0704