


LIMITED COMMON ELEMENTS

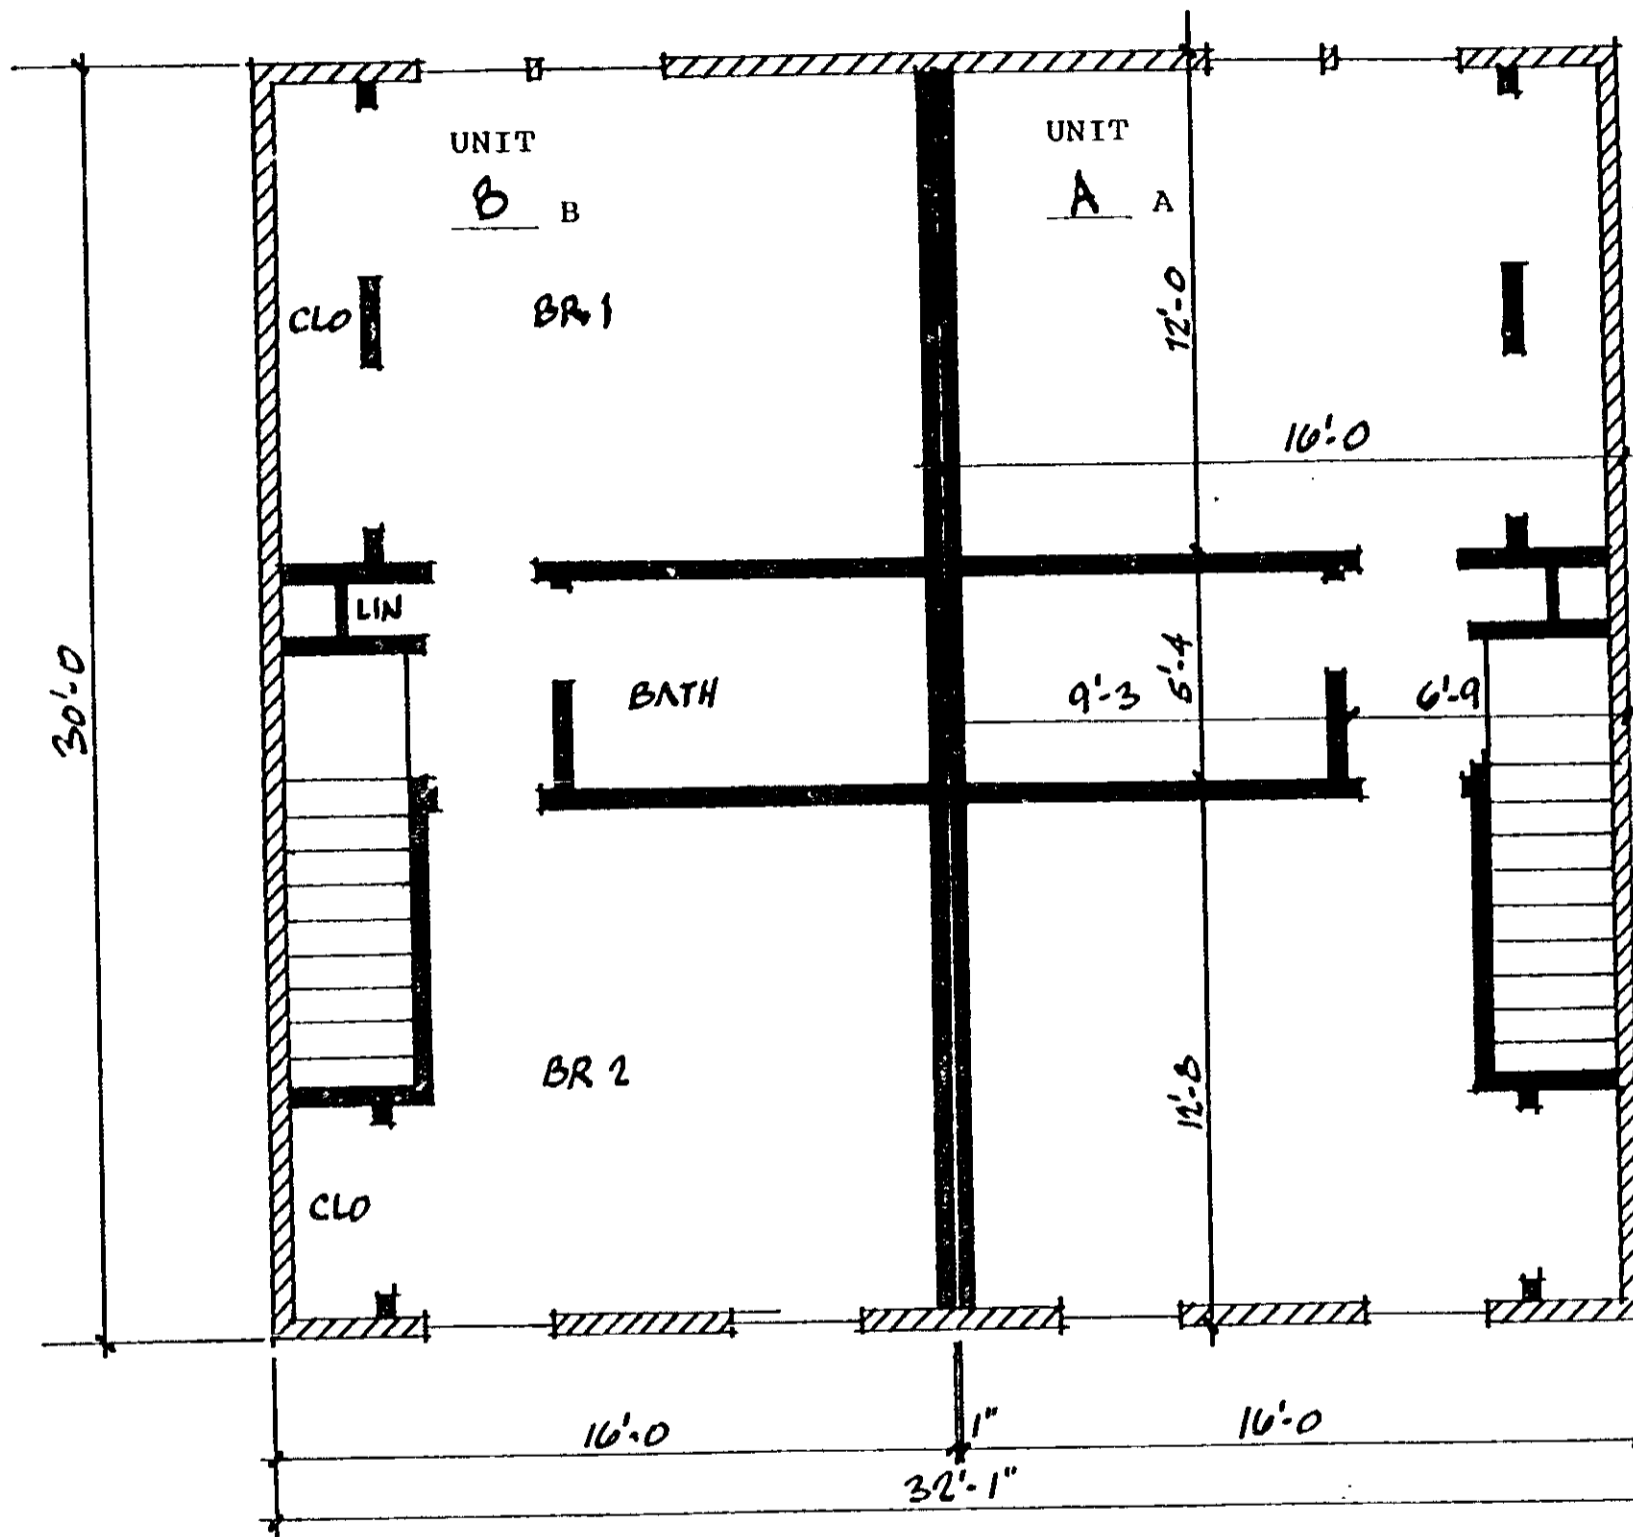


SECOND FLOOR



CERTIFICATE

I, Wade H. Barber, do hereby certify that these plans fully depict within reasonable construction tolerances the layout, location, letter, identification and dimensions of the buildings and dwellings contained therein.

*Wade Barber*

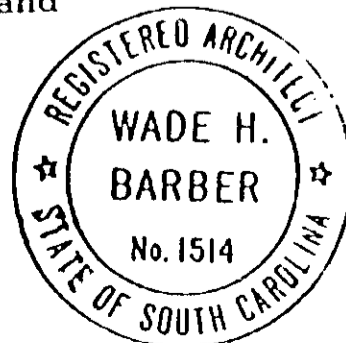

4328 RV-2