


- A. THESE PLANS PERTAIN TO BUILDING 5A
- B. THE BUILDING SHOWN IN THIS PLAN CONSISTS OF ONE 3 BEDROOM TOWNHOUSE
EACH UNIT CONSISTS OF THE SPACE BOUNDED BY THE UNDERCOATED AND/OR UNFINISHED SURFACES OF THE PERIMETER, FLOORS, WALLS, AND CEILINGS.

UNLESS MARKED, ALL INTERIOR AND EXTERIOR ANGLES ARE 90 DEGREES.

- C. ARCHITECT'S CERTIFICATE:
I HEREBY CERTIFY THAT, TO THE BEST OF MY KNOWLEDGE, THE INFORMATION SHOWN IS TRUE AND CORRECT.

Joe W. Miller
Joe W. Miller, AIA S.C. Reg. No. 658

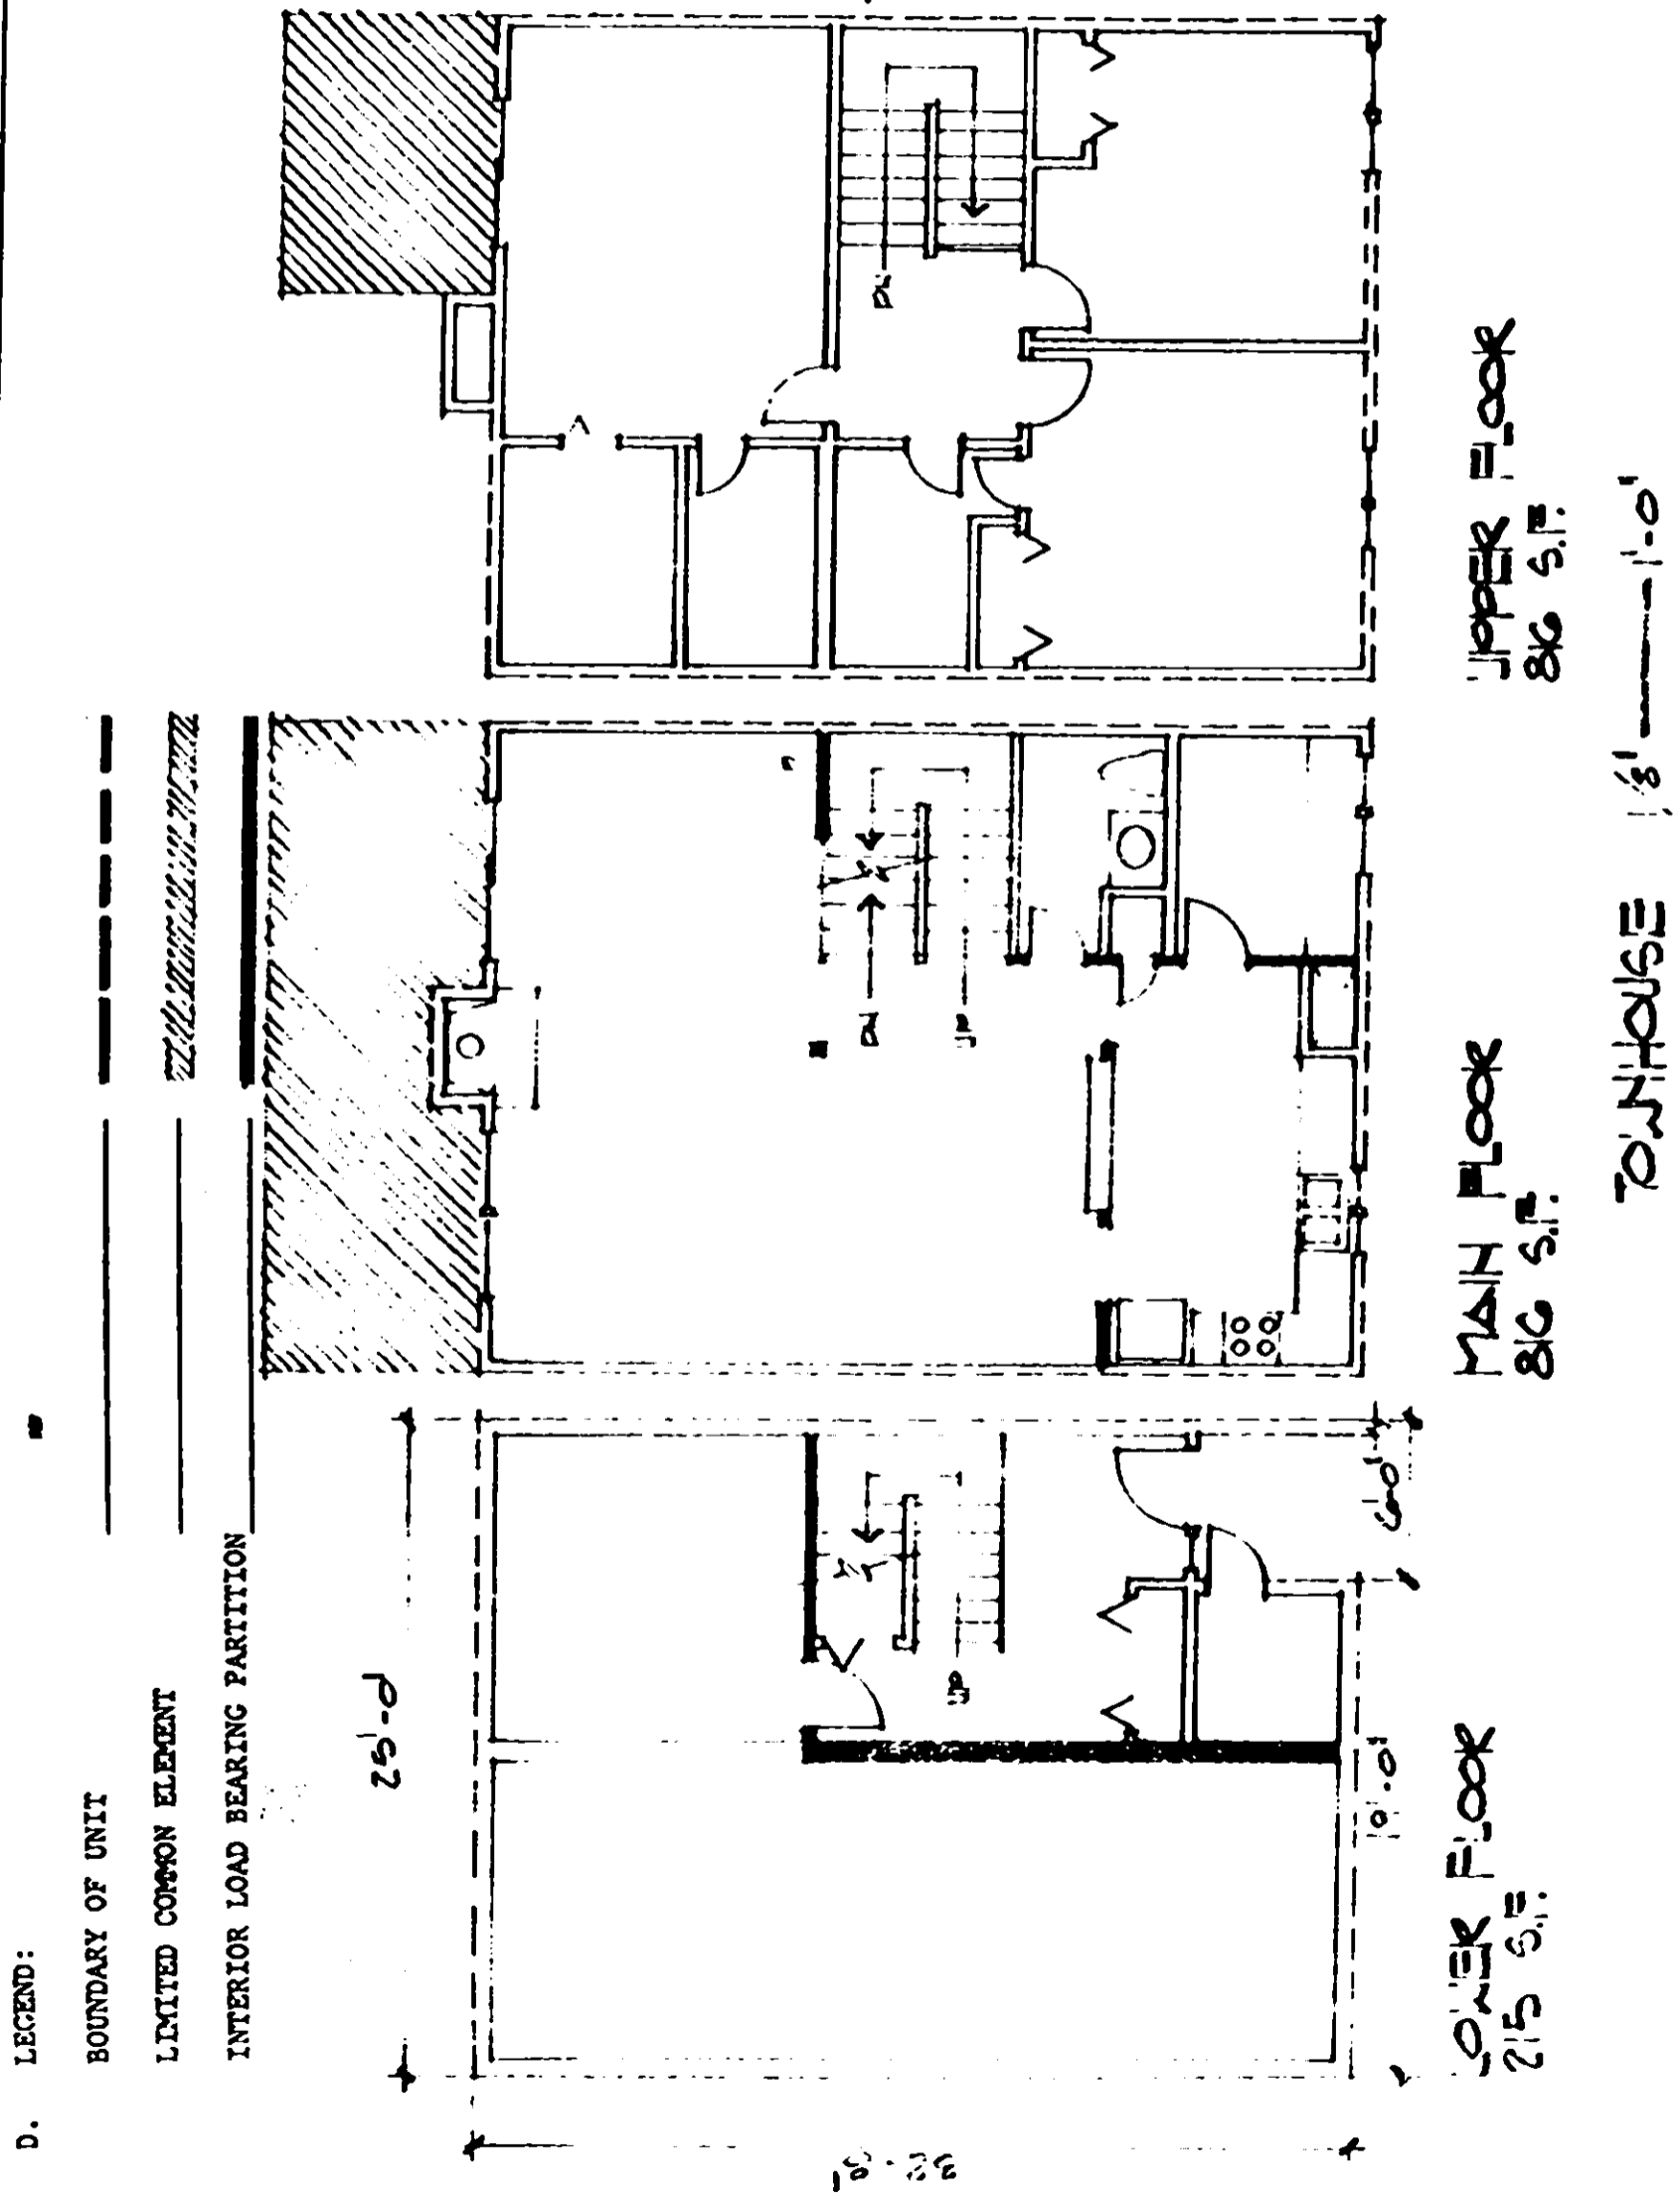

0484

4328 RV-2