


0523



SLOAN

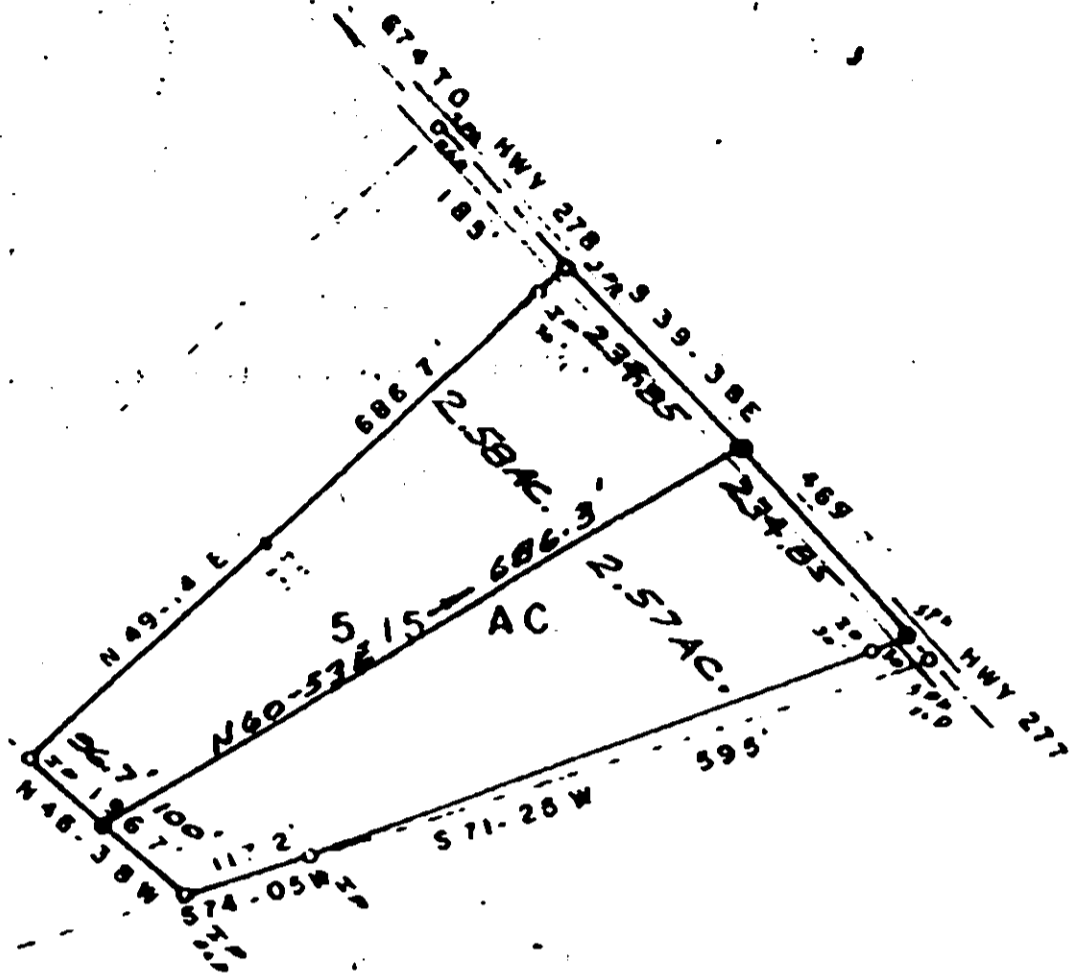

PROPERTY OF
 E. T. & EULA BARNETT
 NEAR ~~GOWENSVILLE~~ GREER, SC. 8 MI NE.
 GREENVILLE COUNTY SOUTH CAROLINA
 SURVEYED APRIL 11, 1977
 SCALE 1" = 200'

THIS IS TO CERTIFY THAT ON THIS DATE I SURVEYED THE PROPERTY SHOWN HEREON AND THE LINES ARE
 AS SHOWN THAT THE BUILDINGS OR WALLS DO NOT ENCRUMBER OR ADJOINING PROPERTY, AND THAT THE BUILDINGS OR
 WALLS OF ADJACENT PROPERTY DO NOT ENCRUMBER ON THIS EXCEPT AS SHOWN
 PLAN BOOK REF. BOOK 555 PAGE 429 SEE REF. BOOK 935 PAGE 357

JAMES V. GREGORY
 Land Surveyor
 Campobello, S. C.

RECORDED MAR 2 1981 at 1:00 P.M.

24135

4328 RV.2