


009

EXHIBIT 'B'

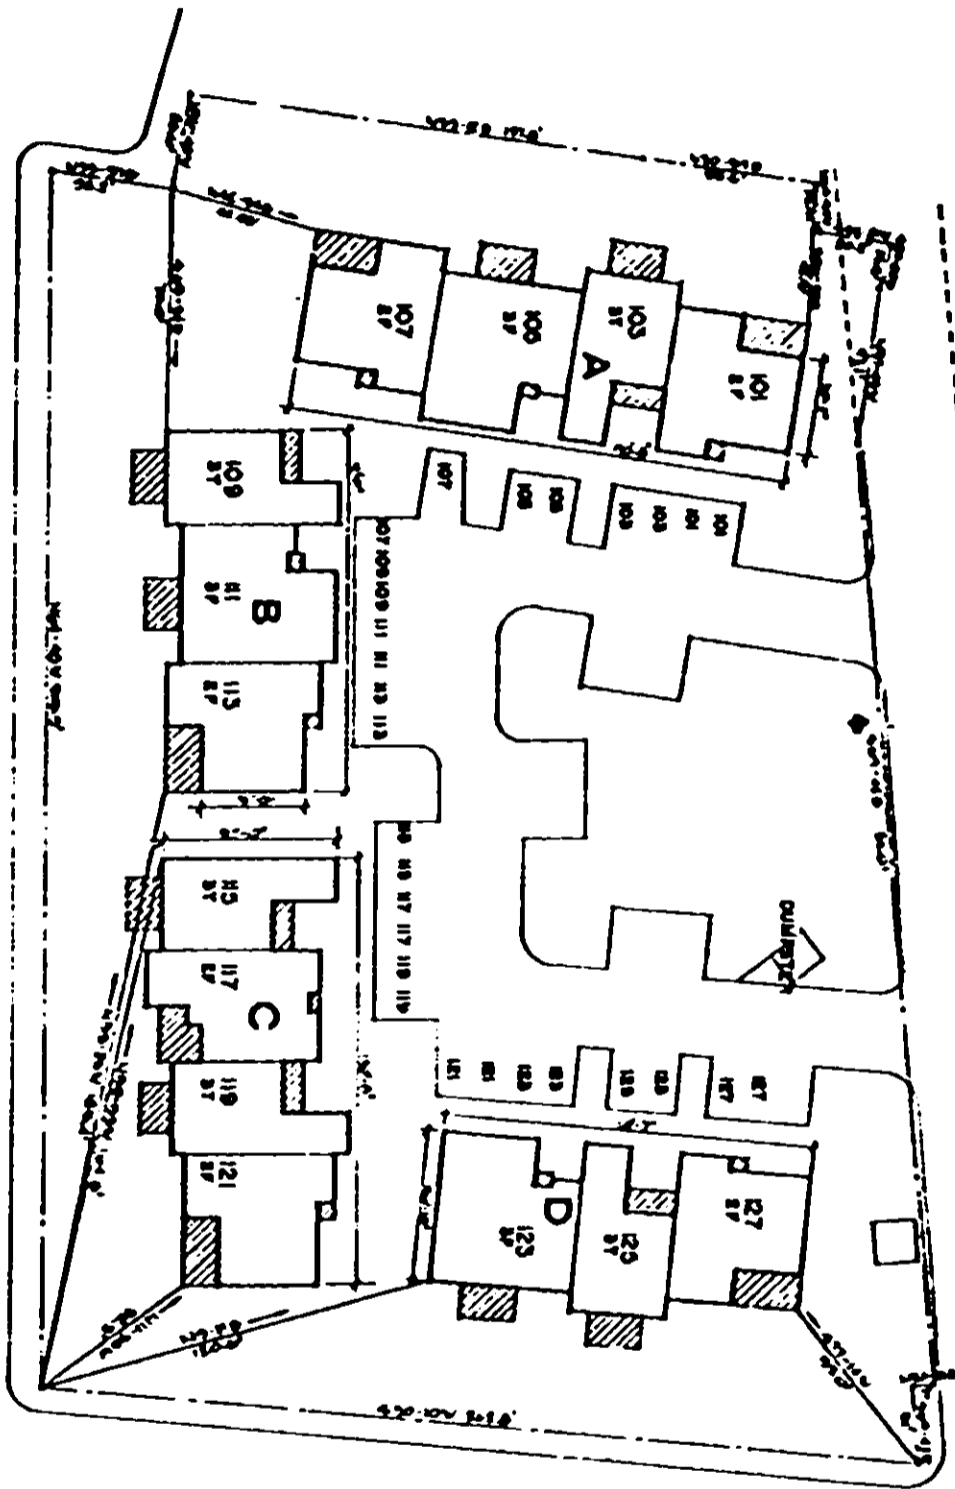

CERTIFICATION: The buildings were located by Freeland and Assoc., registration no. 4781, and to the best of my knowledge were constructed as indicated in this Exhibit
 BY: *[Signature]*
 James L. Townsend, Jr., Architect

LEGEND
 105 UNIT NUMBER
 27 2 BEDRM FLAT
 37 3 BEDRM FLAT
 27 UNIT PARKING SPACE
 27 UNIT COMMON ELEMENT
 EASEMENT
 PROPERTY LINE



	<p>TAP Group</p>	<p>SITE PLAN McDANIEL GREENE SOUTH TOWNHOMES GREENVILLE, SOUTH CAROLINA TOWNSEND ARCHITECTURAL-PLANNING GROUP, GREENVILLE S.C.</p>	

4328 RV-2