


880111111111

Name and Post Office Address of Grantor William C. and Sharon R. Turner File No. \_\_\_\_\_  
Route 2  
Greer, South Carolina 29651  
 Toll Line or Exchange Line tributary to Judson Road SAC Interface (Name)  
Greenville, South Carolina (Exchange)  
 The Property is bounded where the line enters and leaves this property by the property of:  
Judson Road on the Northeast  
 and Valley Street on the Southeast  
 Authority P-43350 Classification R45C  
 Area South Carolina  
 Approved \_\_\_\_\_  
 Title District Manager - Distribution

NORTH

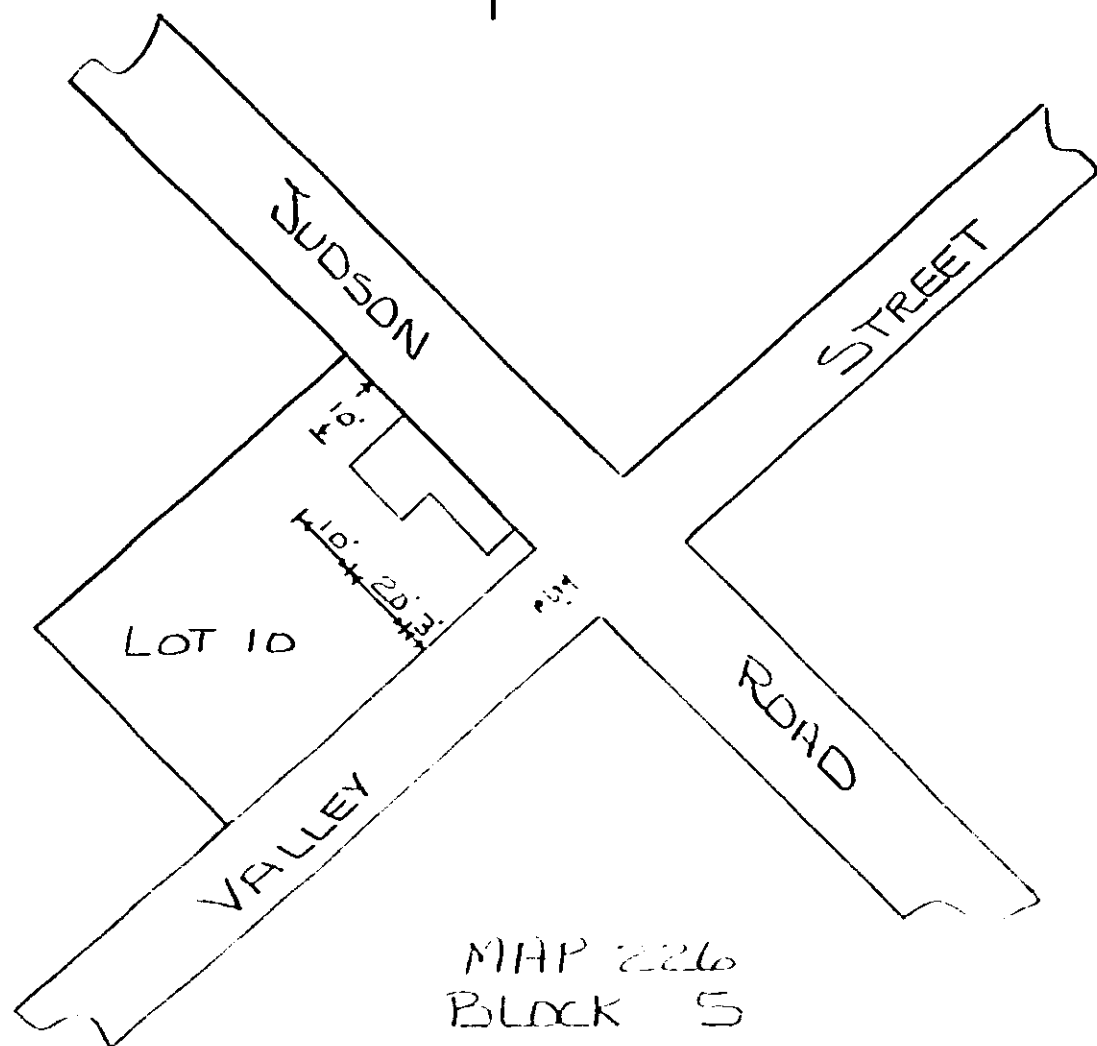

MAP 226  
 BLOCK 5  
 LOT 10

RECORDED MAY 1 1981

at 10:40 A.M.

30512

034

4328 RV-2