


DUKE POWER COMPANY
GREENBRIAR DETAIL LOT
REF: DWG. NO. 156-86

ECON 1148 PAGE 227

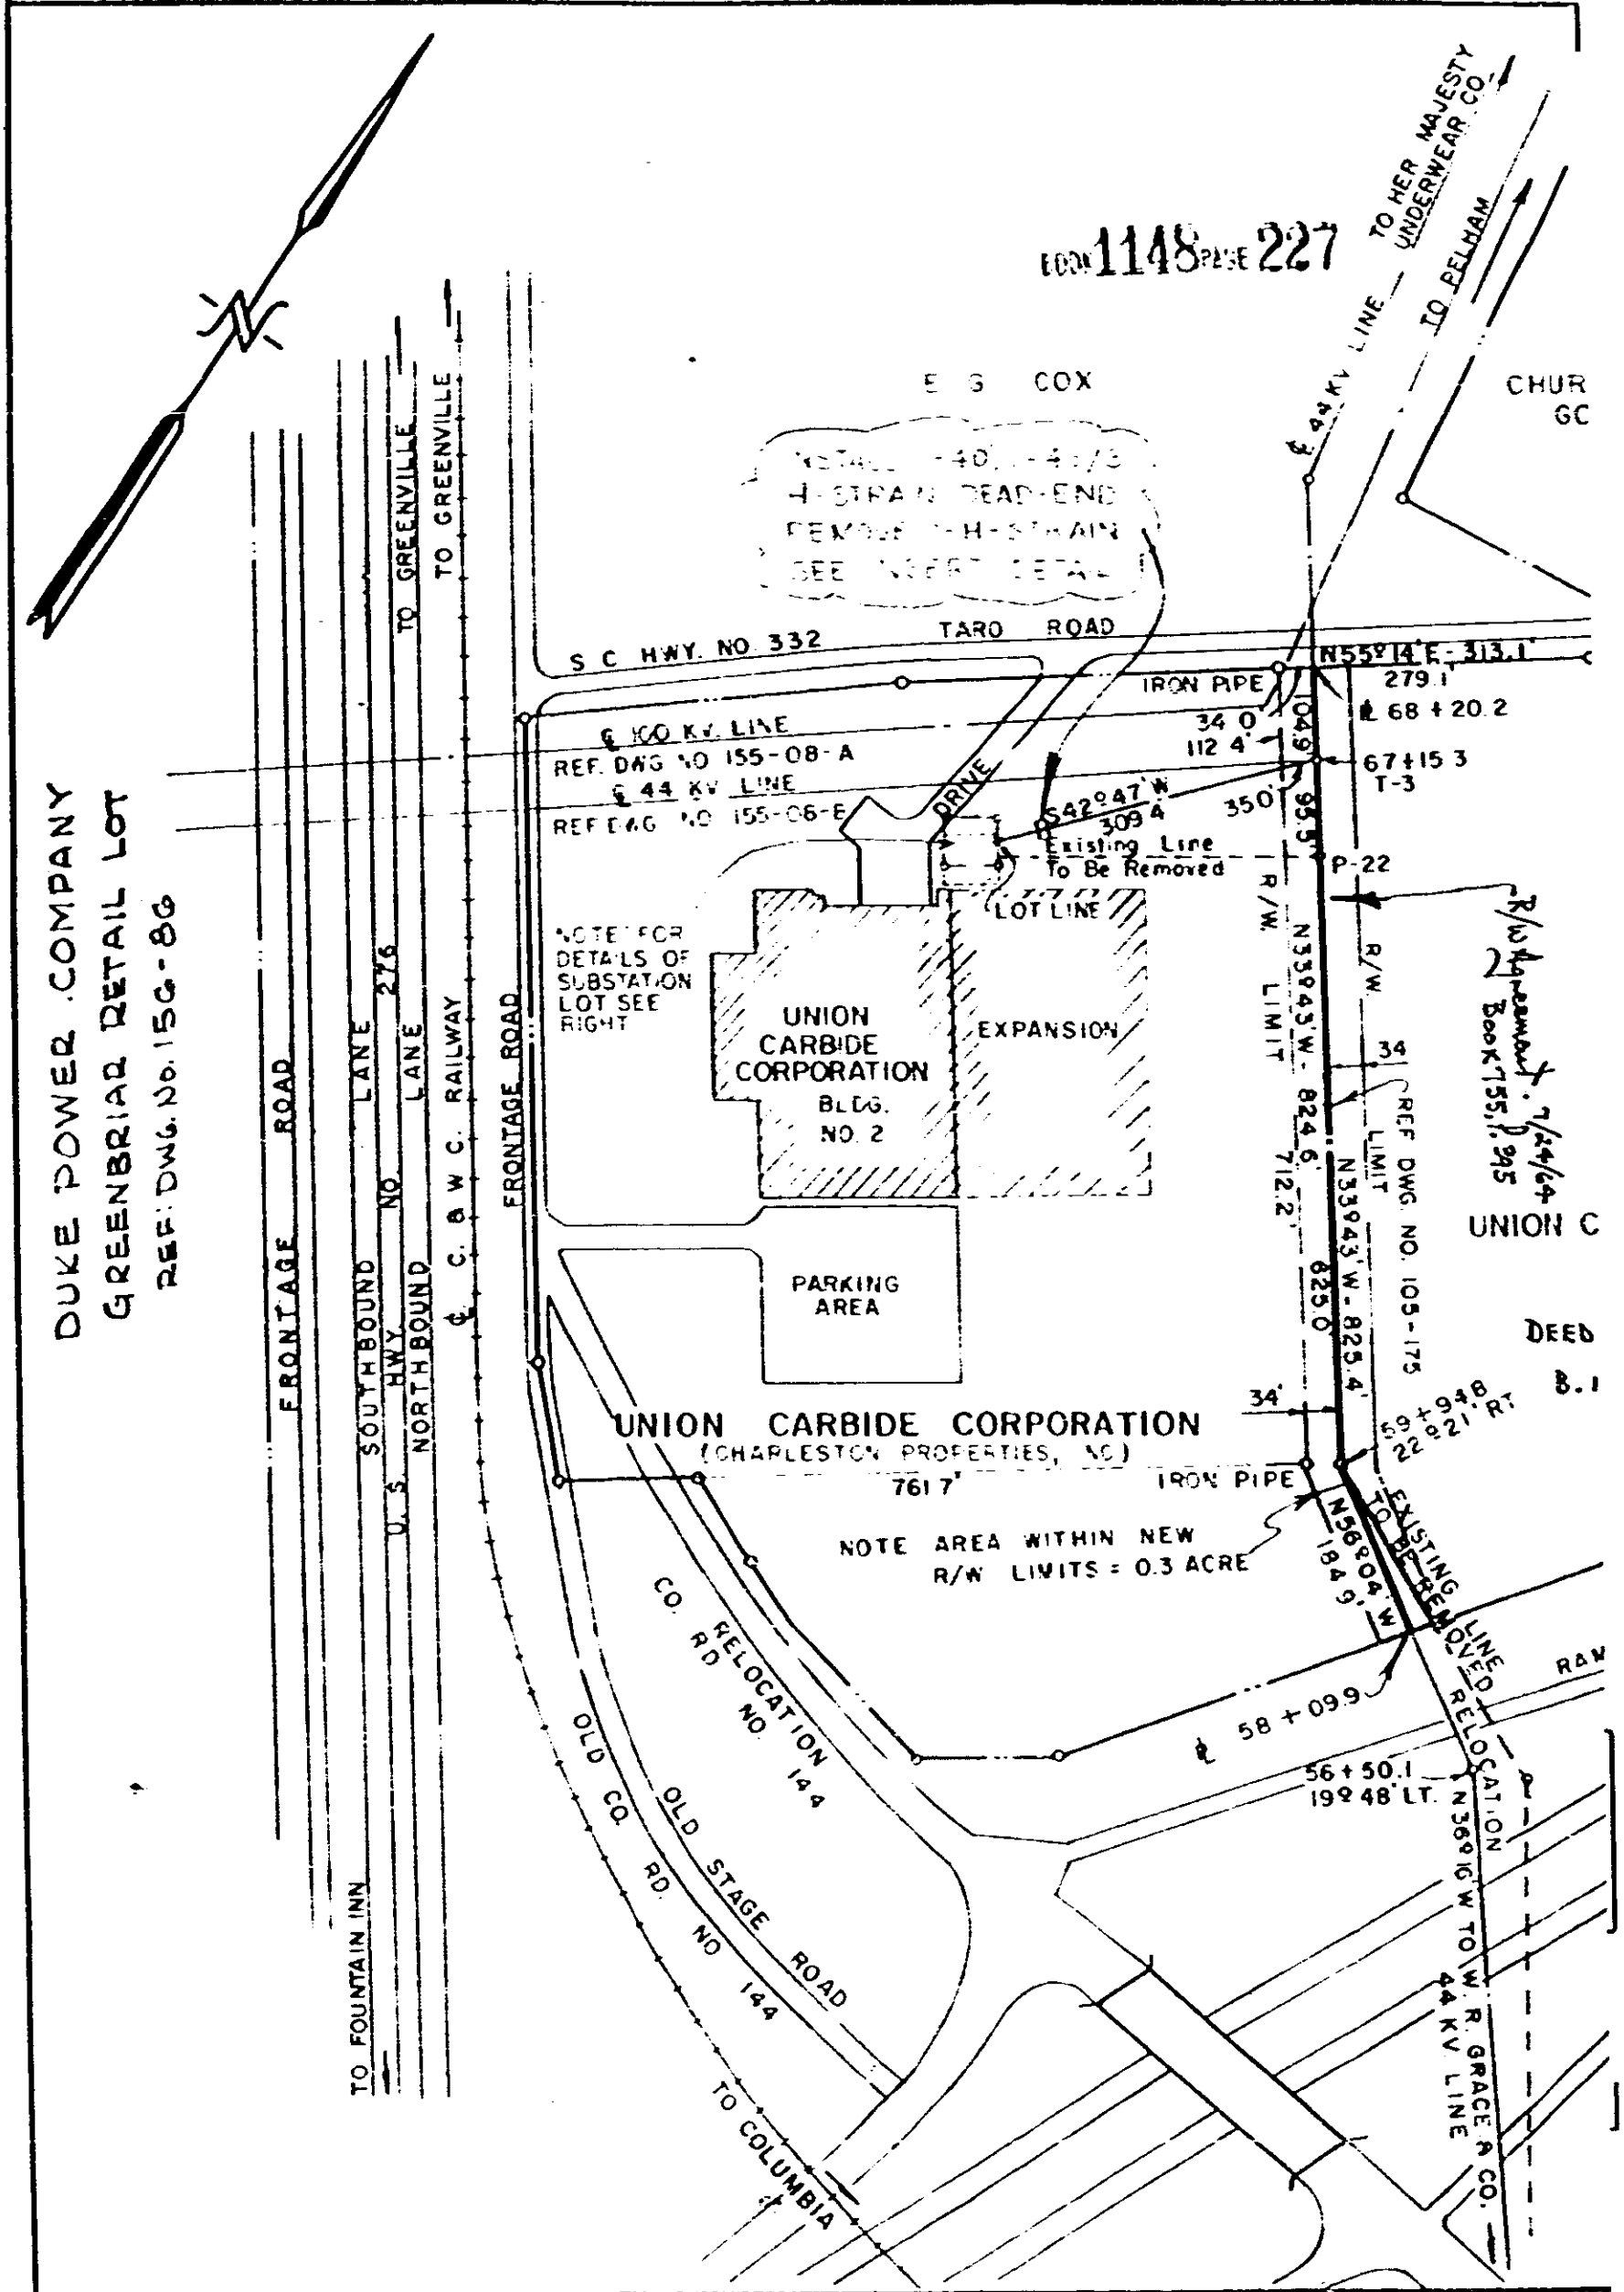

0220

4328 RV-2