

5
2
0
8
9
0

BOOK 1151 PAGE 895

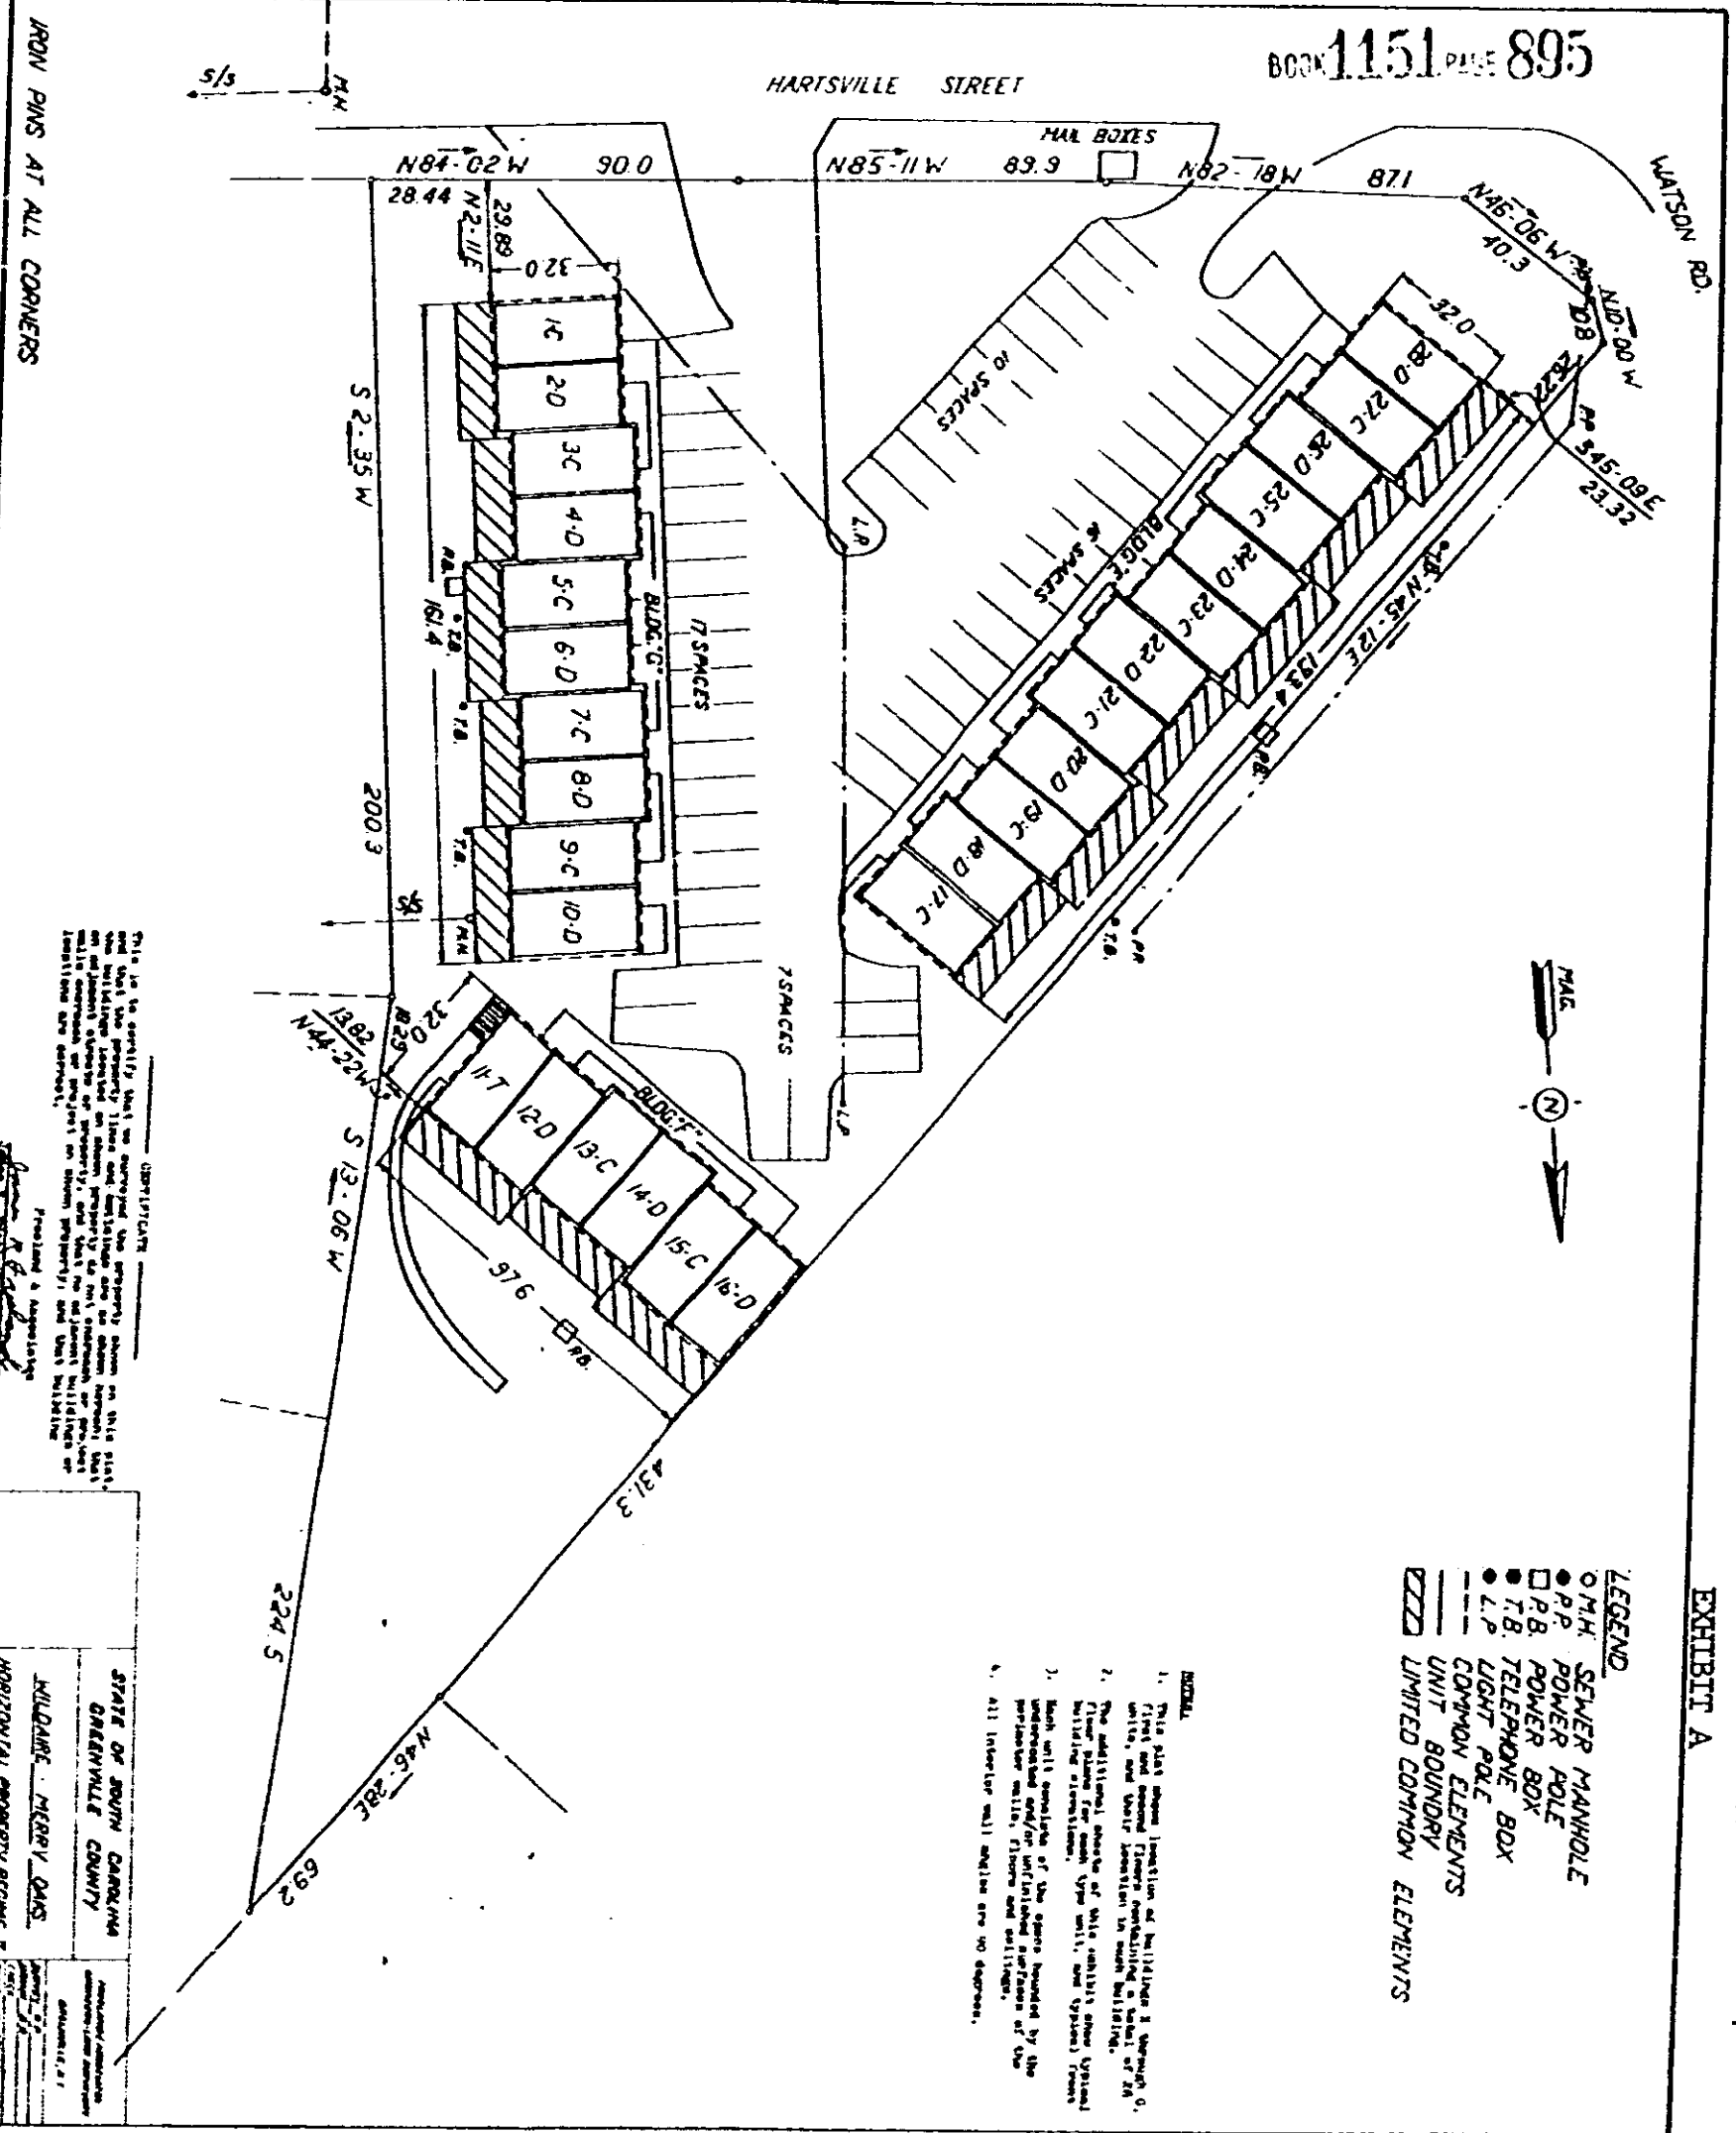


EXHIBIT A

- LEGEND**
- M.H. SEWER MANHOLE
 - P.P. POWER POLE
 - P.B. POWER BOX
 - T.B. TELEPHONE BOX
 - L.P. LIGHT POLE
 - COMMON ELEMENTS
 - UNIT BOUNDARY

NOTES

2. The additional sheets of this exhibit show typical building elevations, site plan, and typical floor plans.
3. Each unit includes of the space bounded by the perimeter walls, floors and ceiling.

IRON PINS AT ALL CORNERS



GREENVILLE COUNTY	
HORIZONTAL PROPERTY RECORD #	

4328 RV-2