



LEGEND:

- UNIT BOUNDARY
- GENERAL COMMON ELEMENTS
- LIMITED COMMON ELEMENTS
- "PORCH" DENOTES COVERED AREA
- "PATH" DENOTES UNCOVERED AREA
- "CONC." DENOTES CONCRETE SLAB ON-GRADE CONSTRUCTION
- "WOOD" DENOTES ABOVE-GRADE WOODEN CONSTRUCTION

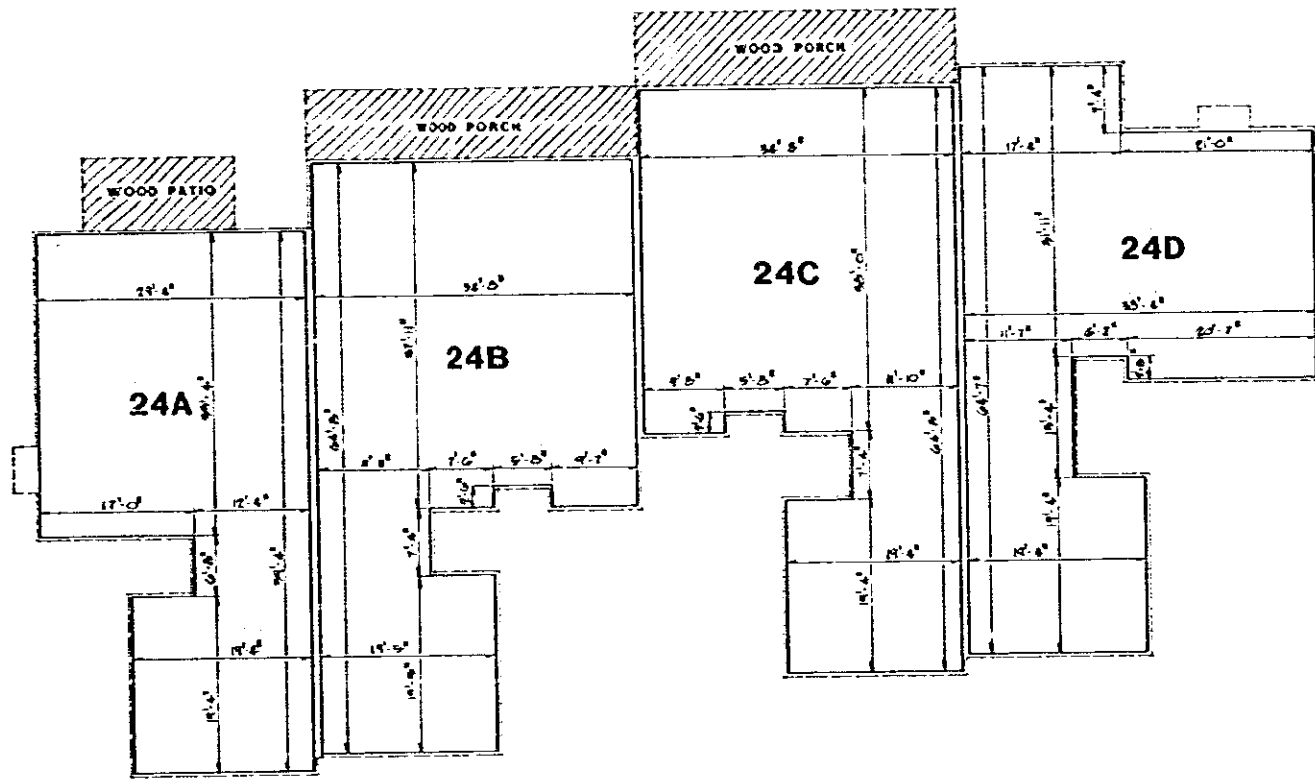

FIRST FLOOR PLAN

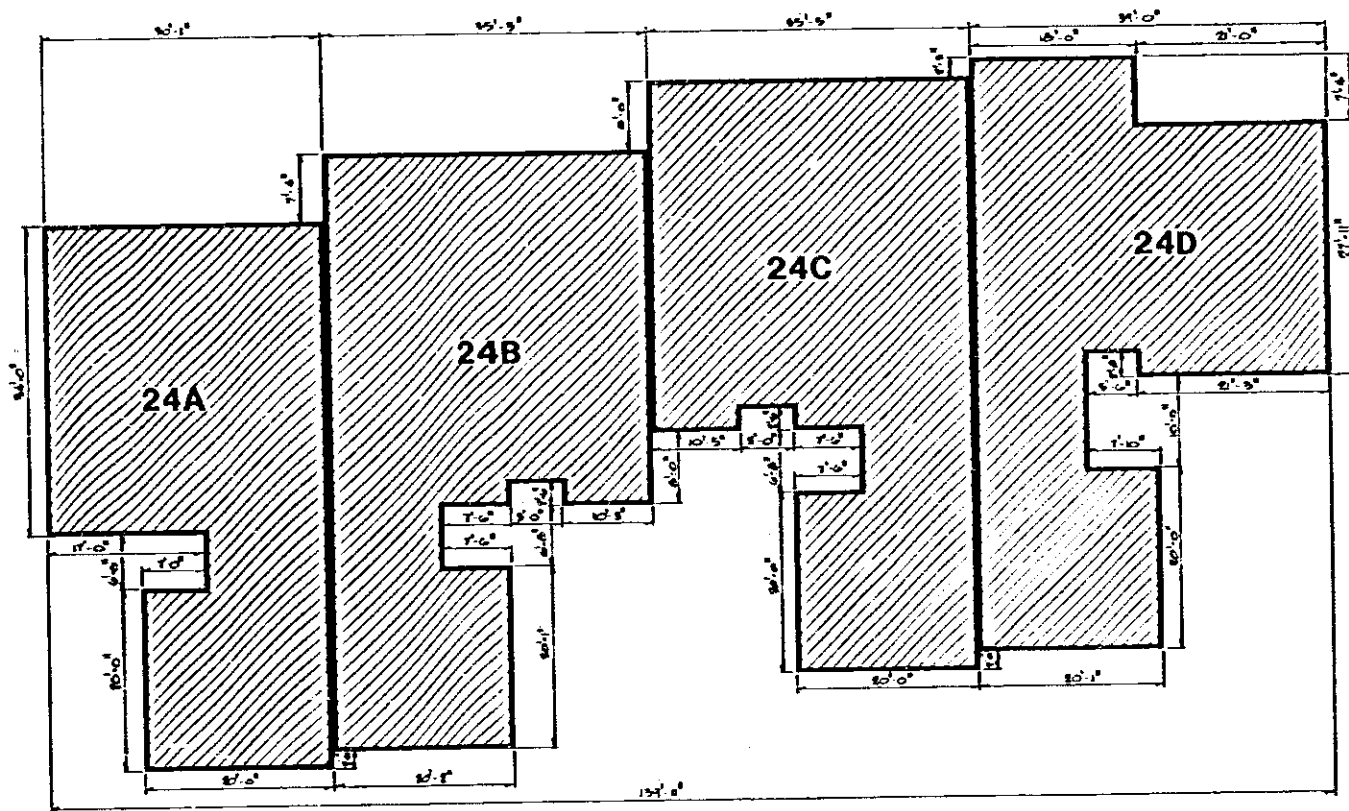


FOUNDATION PLAN

I, ORVILLE V. PLAYER III, HEREBY CERTIFY THAT THE WITHIN FLOOR PLANS ARE TRUE AND CORRECT TO THE BEST OF MY KNOWLEDGE.

Orville V. Player III
ORVILLE V. PLAYER III
S.C. REGISTRATION # 1556

BUILDING 24

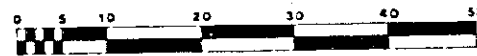

SUGAR CREEK VILLAS
HORIZONTAL PROPERTY REGIME

EXHIBIT B SHEET 6



MILLER/PLAYER & ASSOCIATES
ARCHITECTS AND PLANNERS, LTD.

James D. Miller, A.S.A. / Orville V. Player, III / Robert C. Coffin

