


EXHIBIT A

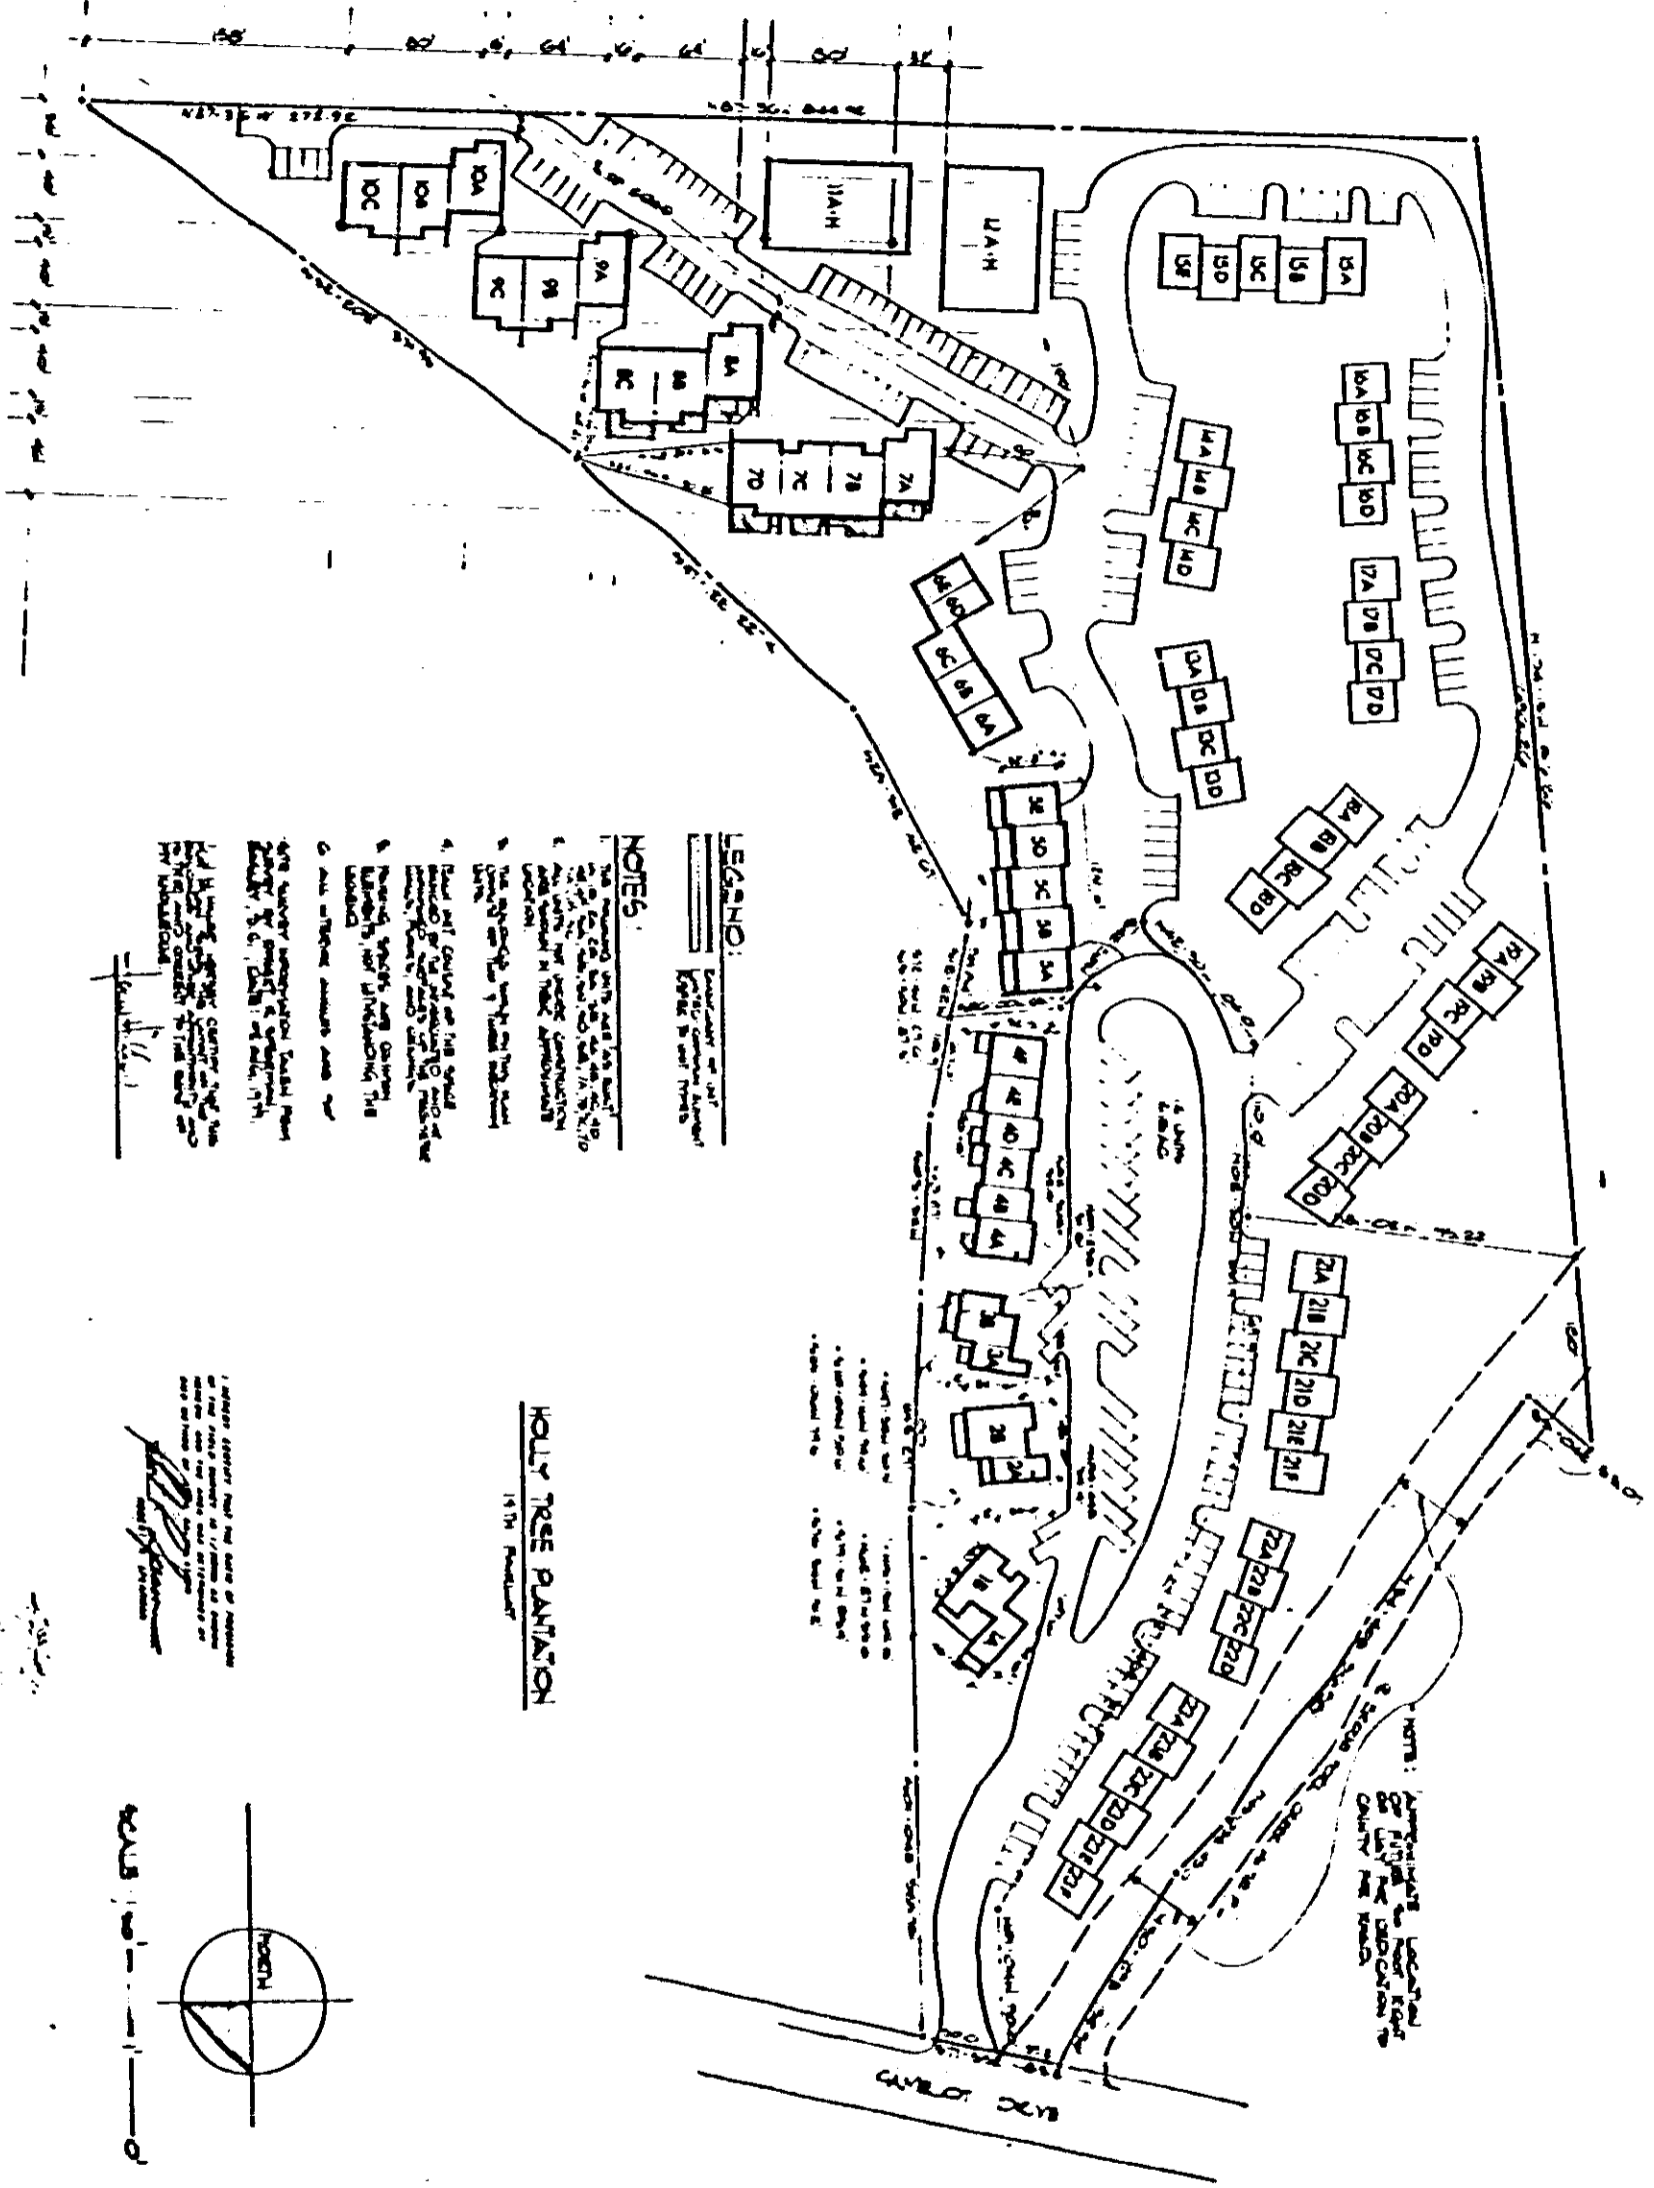

HOLY TREE PLANTATION



NOTES:

HOLY TREE PLANTATION


I hereby certify that the above is a true and correct copy of the plan as shown to me by the applicant and that I have not made any alterations or additions thereto.
 [Signature]
 [Title]

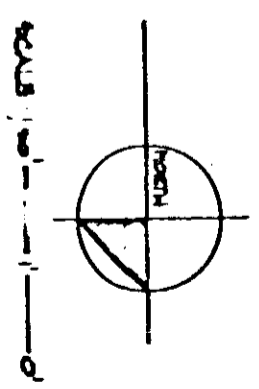

0545

4328 RV-2