


BCOM 1155 PAGE 304

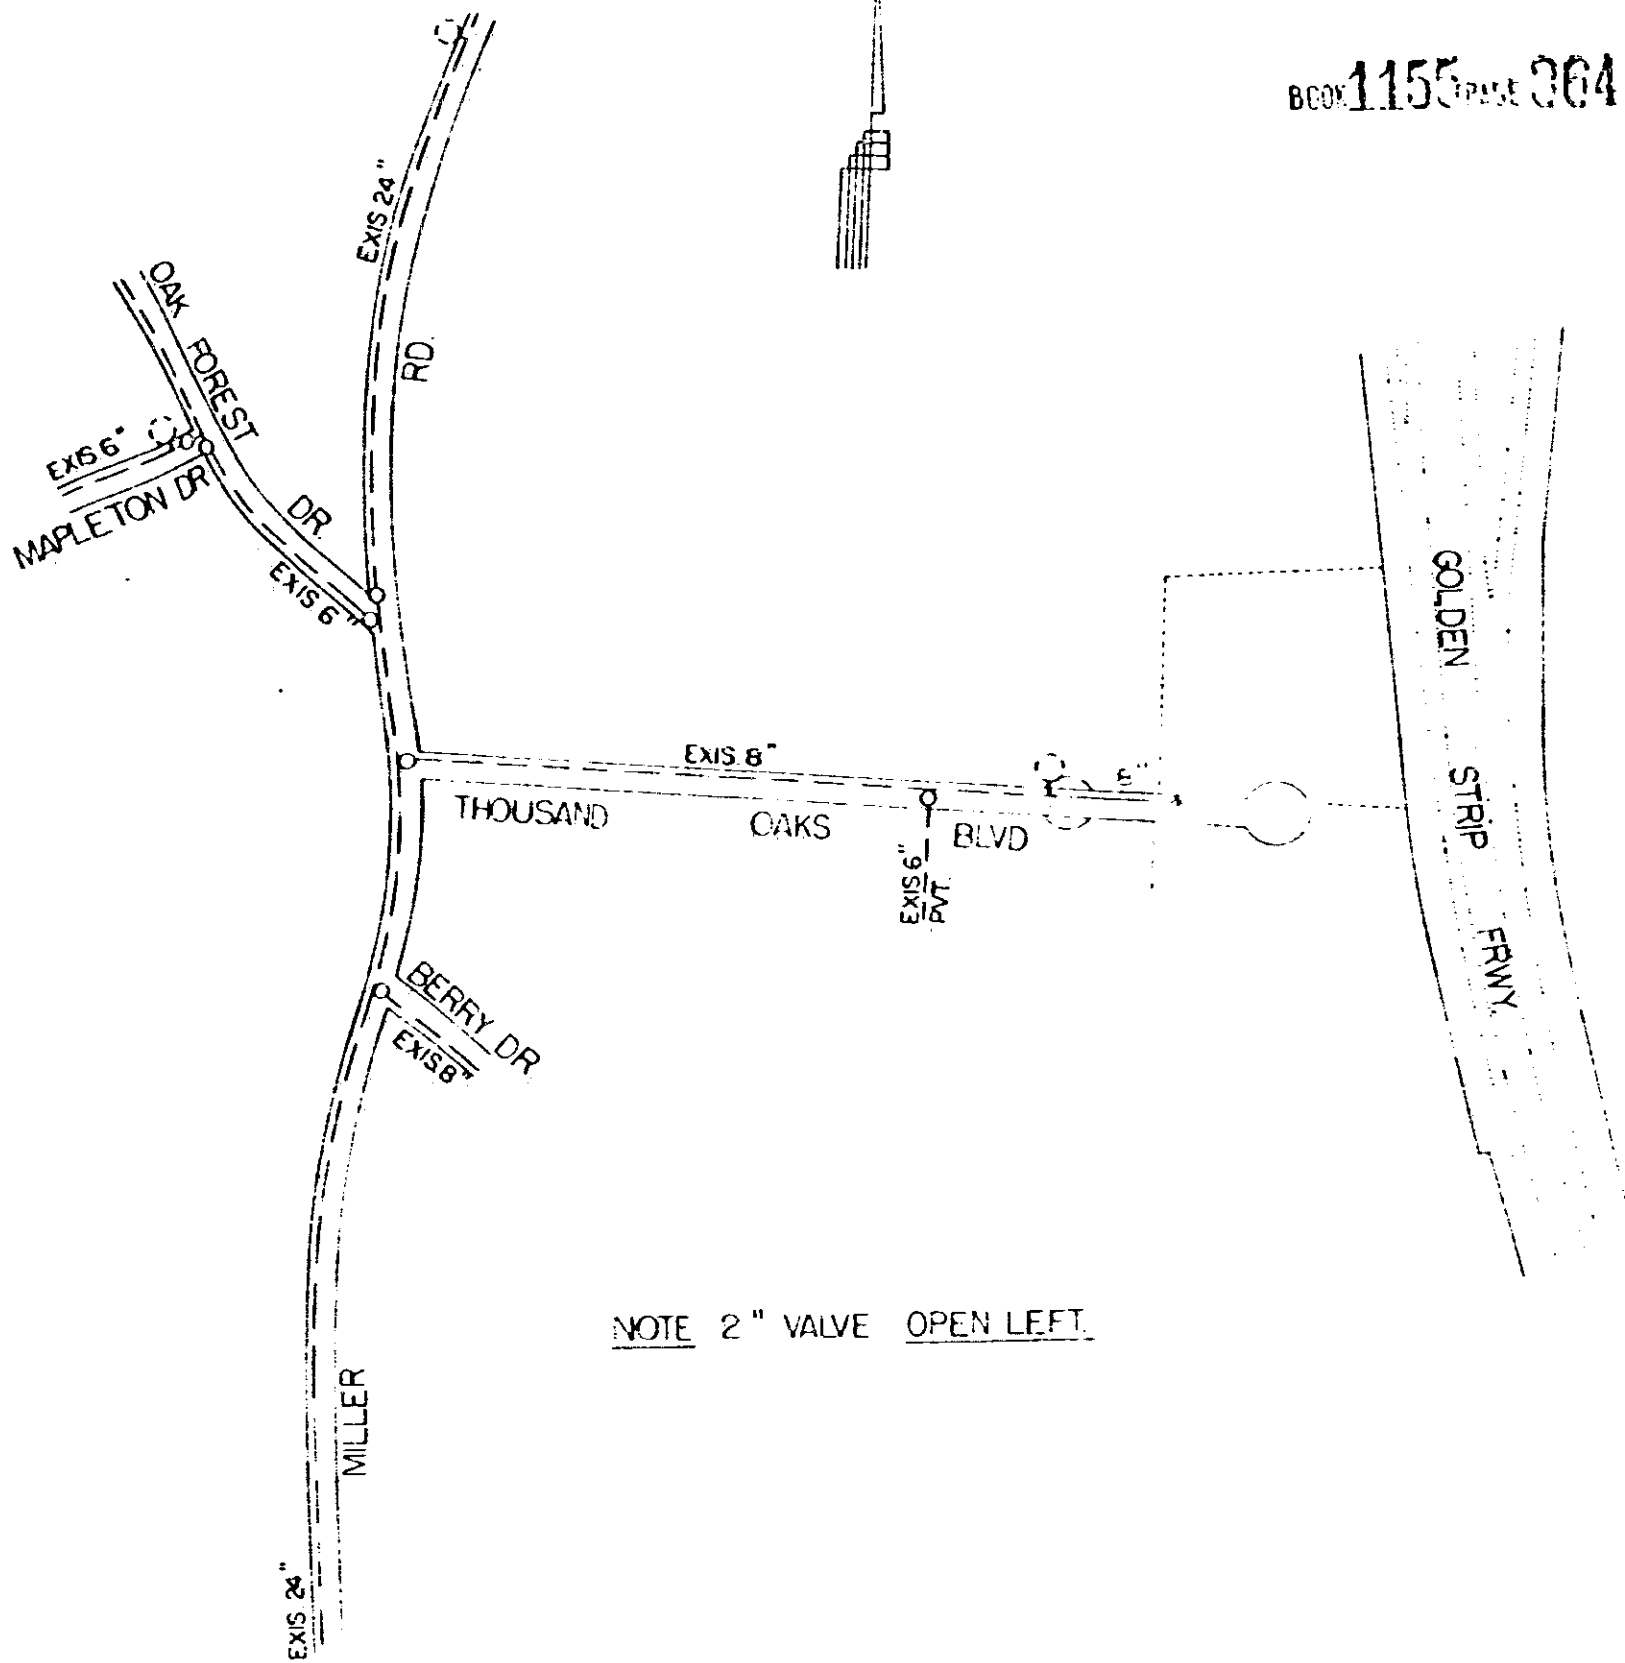

NOTE 2" VALVE OPEN LEFT.

STA=87 PSI.
FLOW=1400GPM

Material List:

8" D. I. Pipe	-	216'
2" Valve	-	1

THOUSAND OAKS BLVD. EXT.
JULY, 1981 SCALE 1" = 400'

Mr. Henry D. Prickett
to
Commissioners of Public Works
of the City of Greenville, S. C.
August 25, 1981
BLK Book 547.3-1-75.8

RECORDED SEP 21 1981
at 10:40 A.M.

7283

0 3 6 4

4328 RV-2