


EXHIBIT 'B'

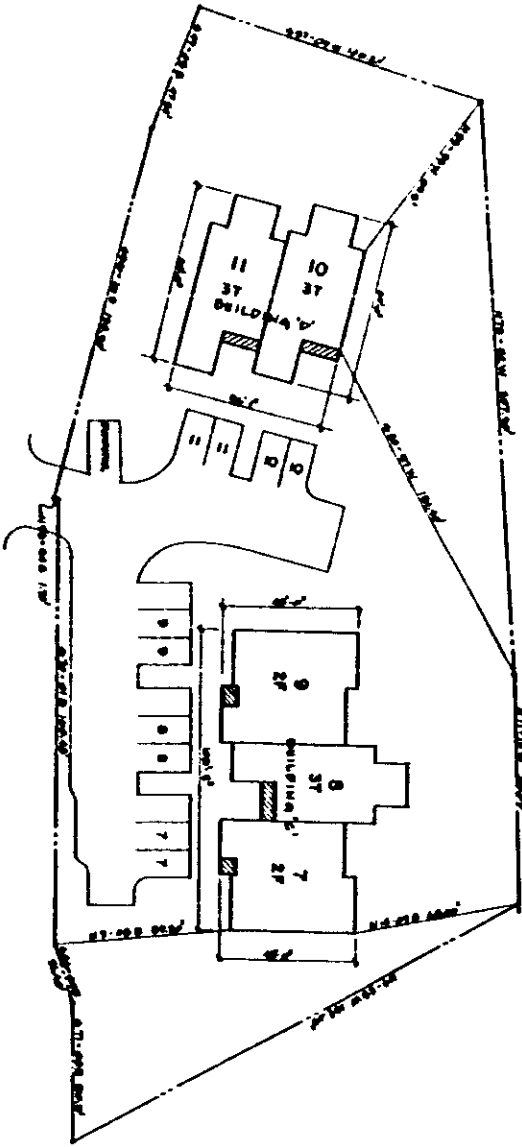

- LEGEND
- UNITED COMMON ELEMENT
 - 7 UNIT NUMBER
 - 8 2 BEDROOM FLAT
 - 9 3 BEDROOM TOWNHOUSE
 - BOUNDARY OF UNIT
 - BOUNDARY LIMIT

CERTIFICATION: THE BUILDINGS WERE LOCATED BY FIELD AND ASSOCIATES, INCORPORATION NO. 479, AND TO THE BEST OF MY KNOWLEDGE WERE CONSTRUCTED AS INDICATED IN THIS EXHIBIT.
 BY: *James L. Townsend*
 JAMES L. TOWNSEND, A.P., ARCHITECT



1	2	3	4	5	6	7	8	9	10
---	---	---	---	---	---	---	---	---	----

TAP GROUP

SITE PLAN
 Mc DANIEL GREEN CREEKSIDE TOWNHOMES
 GREENVILLE, SOUTH CAROLINA
 TOWNSEND ARCHITECTURAL PLANNING GROUP
 GREENVILLE, S.C.

1	2	3	4	5	6	7	8	9	10
---	---	---	---	---	---	---	---	---	----

EXHIBIT B, 1

9 9 31 9

4328 RV-2