

Name and Post Office Address of Grantor THOMAS M. TUCKER  
2507 OLD EASLEY BRIDGE RD  
GREENVILLE, S.C. 29611

Toll Line or Exchange Line tributary to GREENVILLE, S.C. (Name) (Exchange)


The Property is bounded where the line enters and leaves this property by the property of:  
MURRELL ROAD on the SOUTH  
and ALICE R. TRIPP on the WEST

Authority HE2-8106G Classification R 45C

Area SOUTH CAROLINA

Approved \_\_\_\_\_

Title \_\_\_\_\_

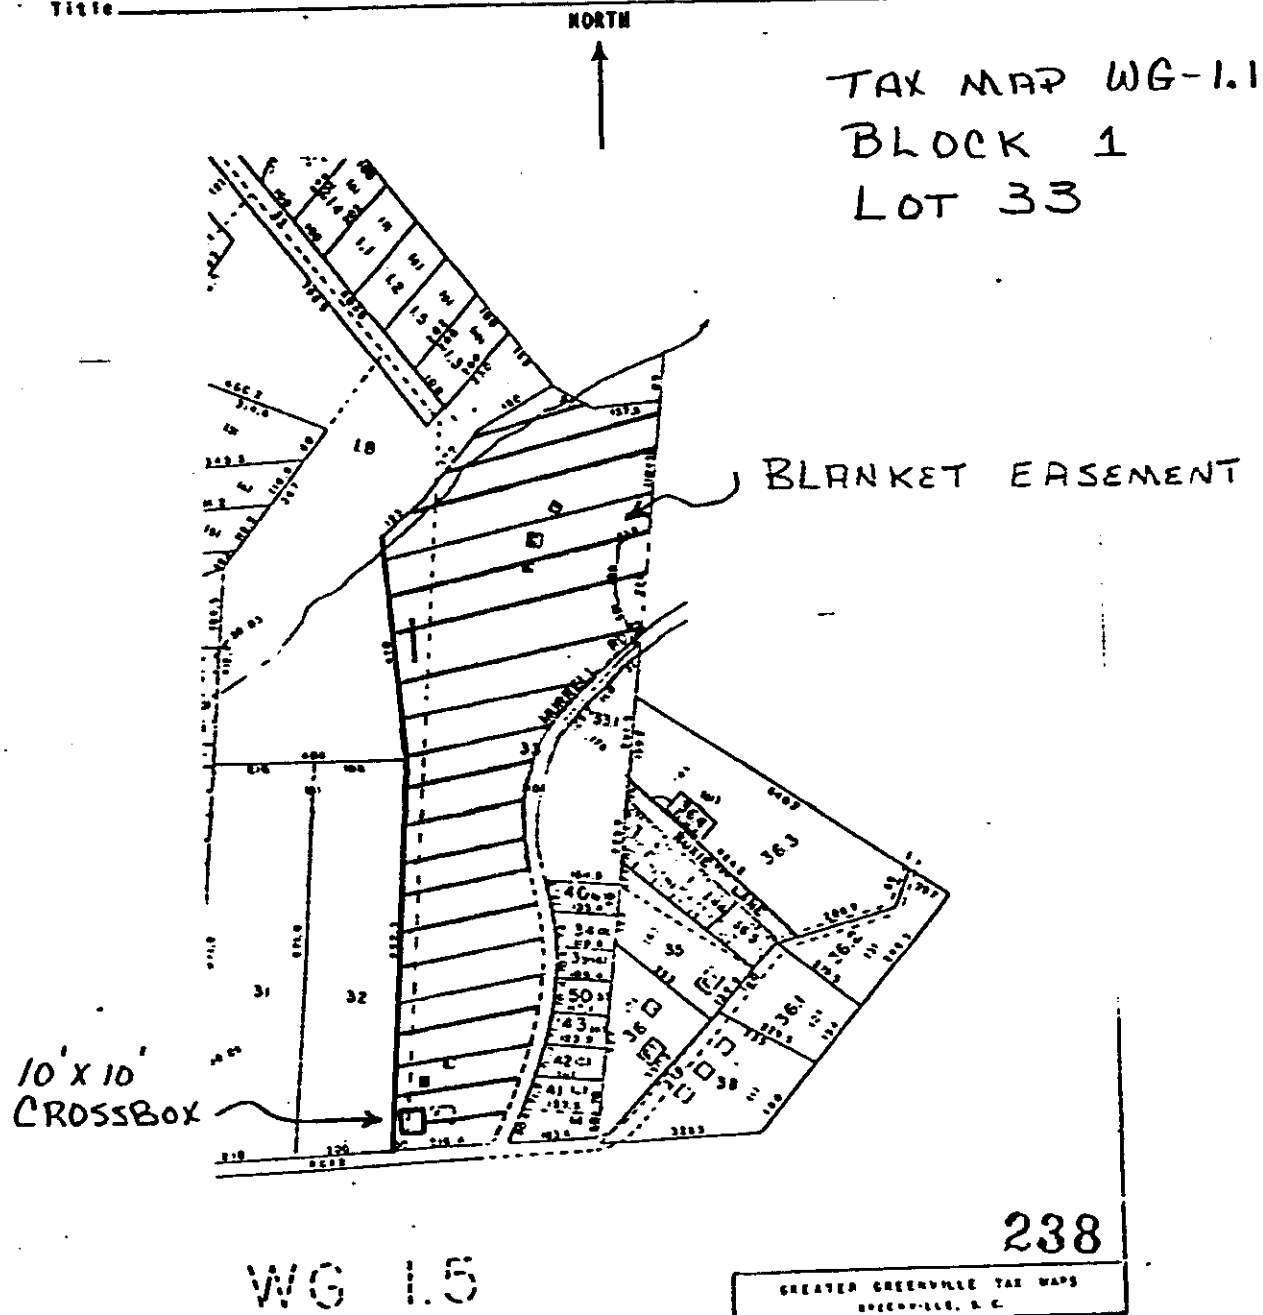

GREATER GREENVILLE TAX MAPS		
GREENVILLE, S.C.		
TAX DISTRICT	MAP NUMBER	REVISION
156	WG-1.1	
161		
SCALE 1" = 200'		INDEX-14

RECORDED **MAY 19 1982** at 11:10 A.M. 25714

0104

4328 RV-2