


Vol 127

1510

**SECOND FLOOR PLAN
DORCHESTER HOUSE**

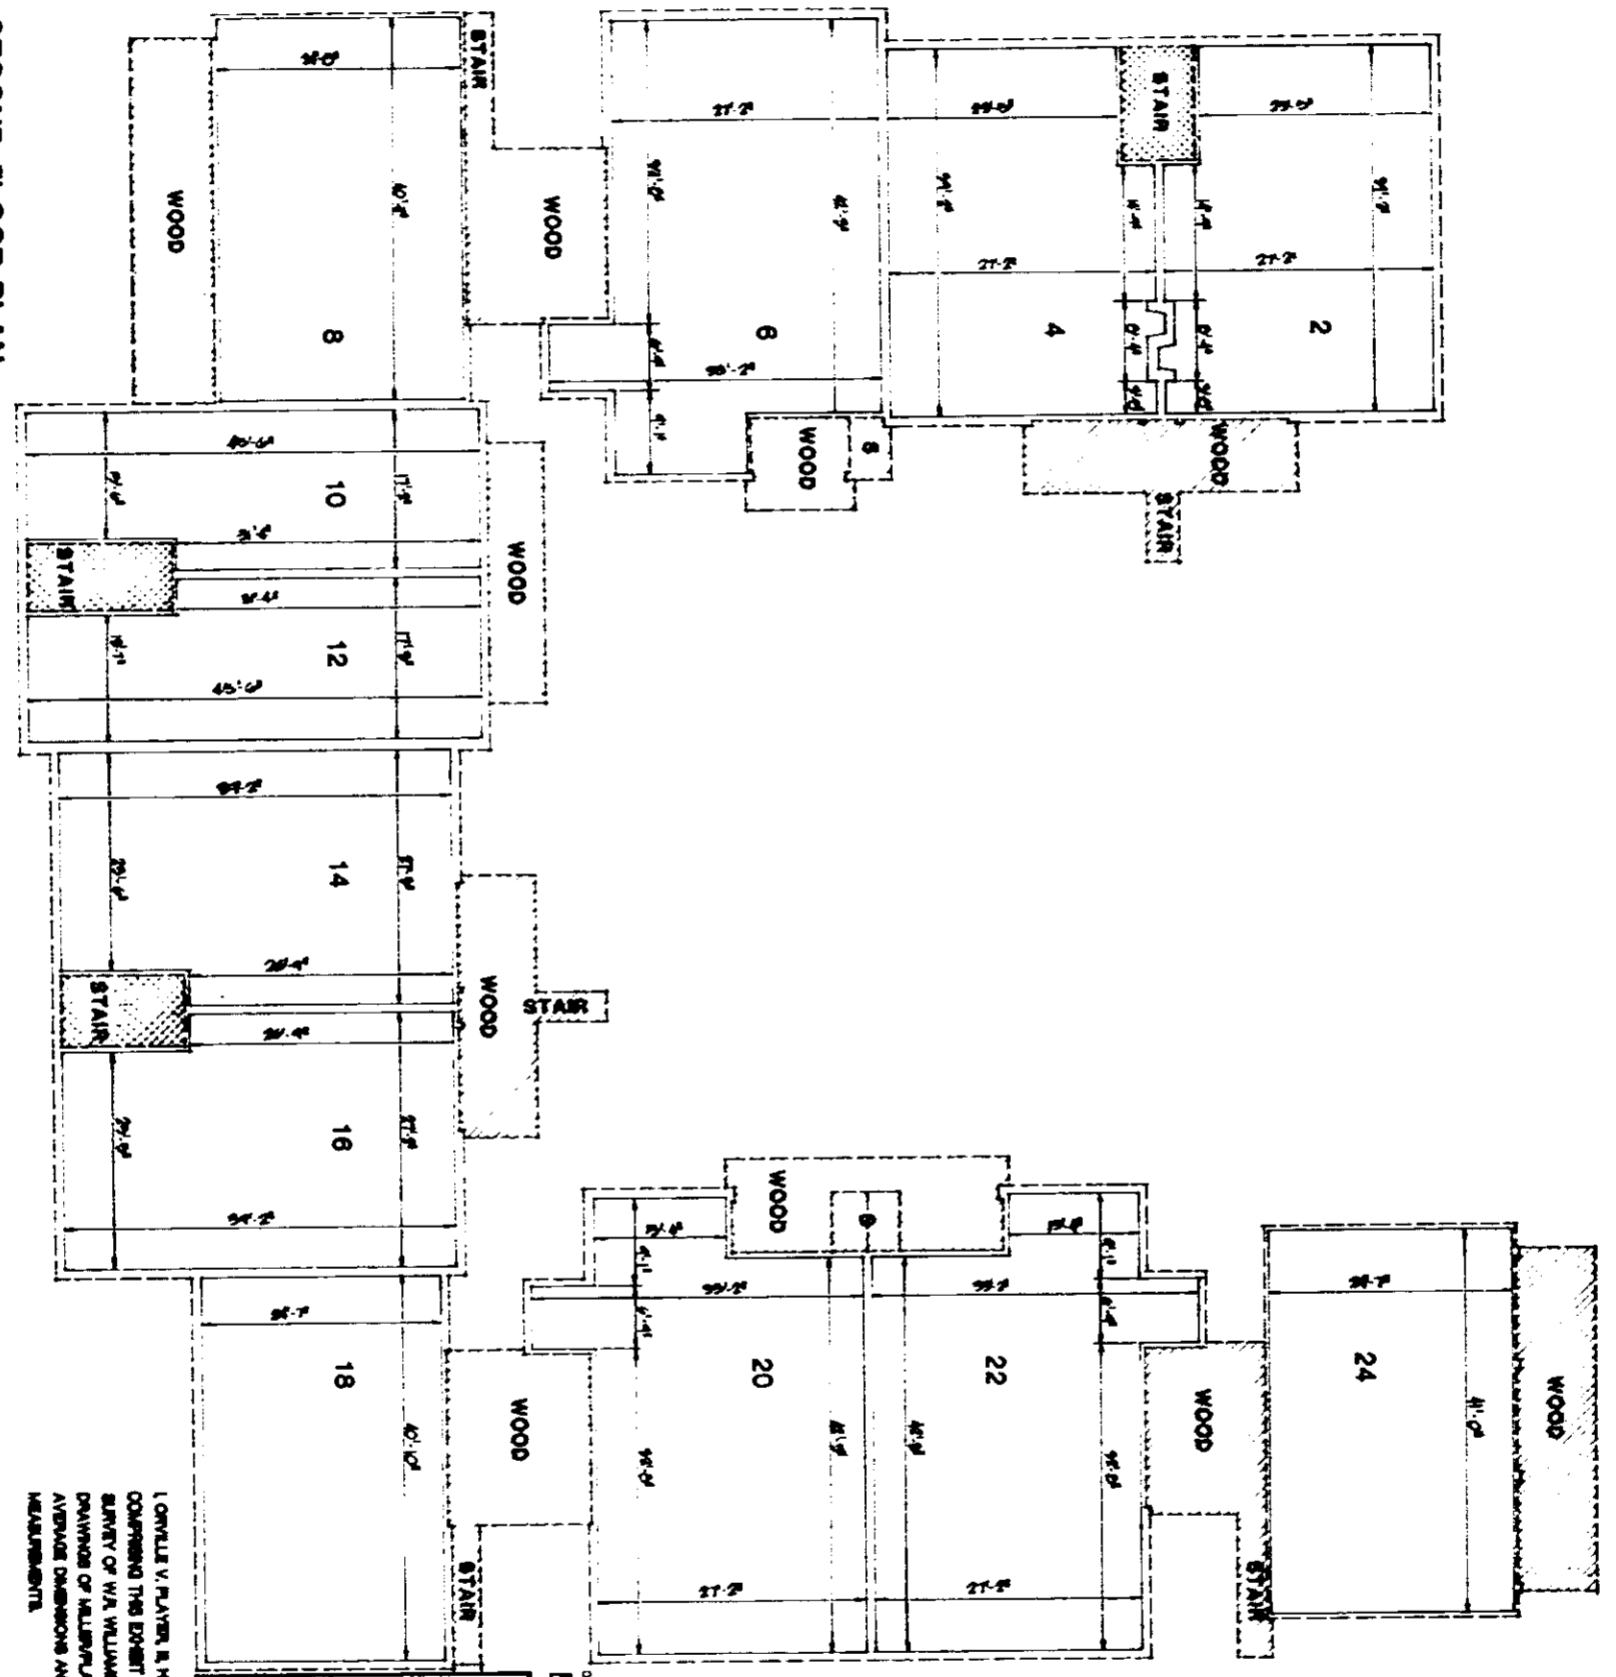

I ORVILLE V. PLAYER, IS HEREBY CERTIFY THAT THE 18 DRAWINGS COMPOSING THIS EXHIBIT ARE CORRECT ON THE BASIS OF THE SURVEY OF W.A. WILLIAMS, JR. AND THAT THE AS BUILT ARCHITECTURAL DRAWINGS OF MILLER/PLAYER AND ASSOCIATES, ARCHITECTS ARE AVERAGE DIMENSIONS AND SHOULD NOT BE TAKEN AS EXACT MEASUREMENTS.

ORVILLE V. PLAYER, II
S.C. REGISTRATION # 1888

LEGEND:

- EXTERIOR WALL LINE
- - - UNIT BOUNDARY
- //// GENERAL COMMON ELEMENTS
- XXXX LIMITED COMMON ELEMENTS
- PORCH DENOTES COVERED AREA
- * S. DENOTES STORAGE AREA
- COHC DENOTES CONCRETE SLAB-OR-GRADE CONSTRUCTION
- WOOD DENOTES ABOVE-GRADE WOODEN CONSTRUCTION



7

**RIVERBEND CONDOMINIUMS
HORIZONTAL PROPERTY REGIME
EXHIBIT B**

NO.	DATE	DESCRIPTION
1	10/1/88	AS BUILT ARCHITECTURAL DRAWINGS
2	10/1/88	AS BUILT ARCHITECTURAL DRAWINGS
**MILLER/PLAYER & ASSOCIATES
ARCHITECTS AND PLANNERS, LTD.**
1010 east north street . greenville, s.c.

James B. Miller, A.A.A. / Orville V. Player, II / Robert C. Cobble



2 AR 8234