


Exhibit A

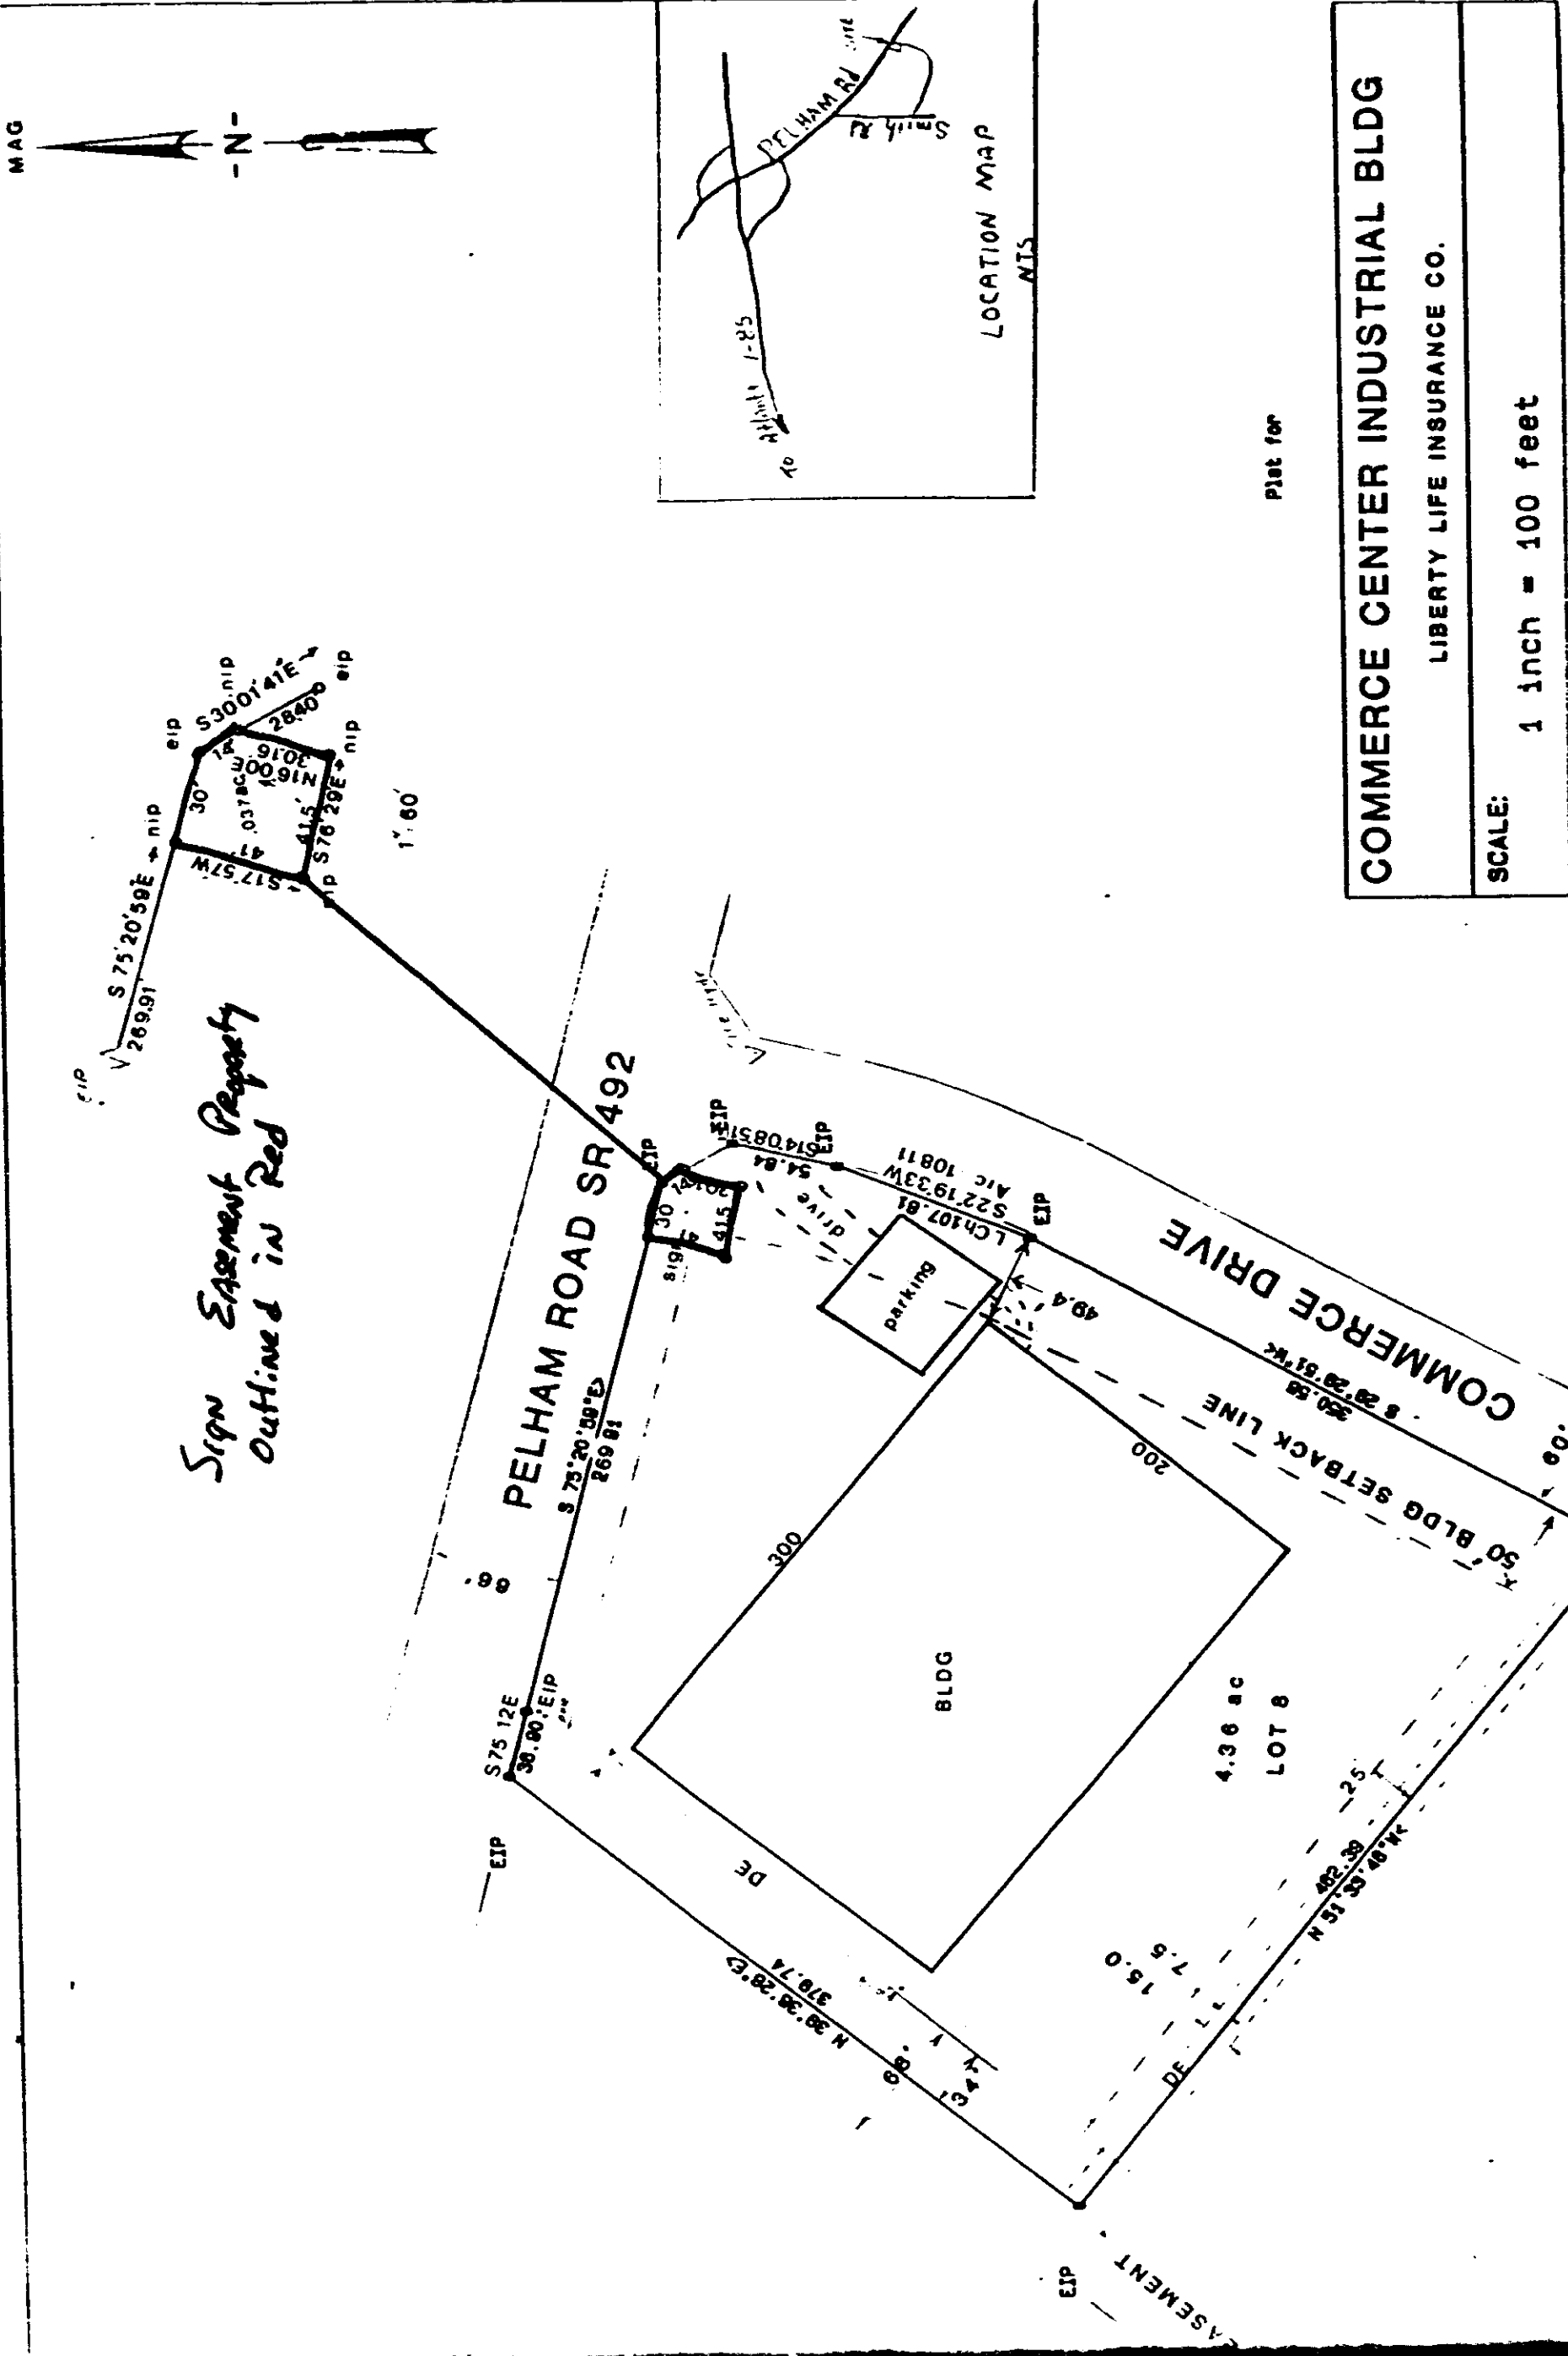

Plot for

COMMERCE CENTER INDUSTRIAL BLDG

LIBERTY LIFE INSURANCE CO.

SCALE: 1 inch = 100 feet

4328 W.2

992