

Name and Address of Applicant  
 LAURA B. FORD  
 28 ALLEN ST  
 GREENVILLE, S.C. 29605

City or Exchange Line or Tributary to  
 GREENVILLE, SOUTH CAROLINA


The Property is bounded where the line enters and leaves this property by the property of:  
 STEVENS STREET on the SOUTH  
 DONALD D COX on the NORTH

Authority P-43659 Classification R-45-C

Area GREENVILLE SOUTH CAROLINA

Approved \_\_\_\_\_  
 Title \_\_\_\_\_

NORTH

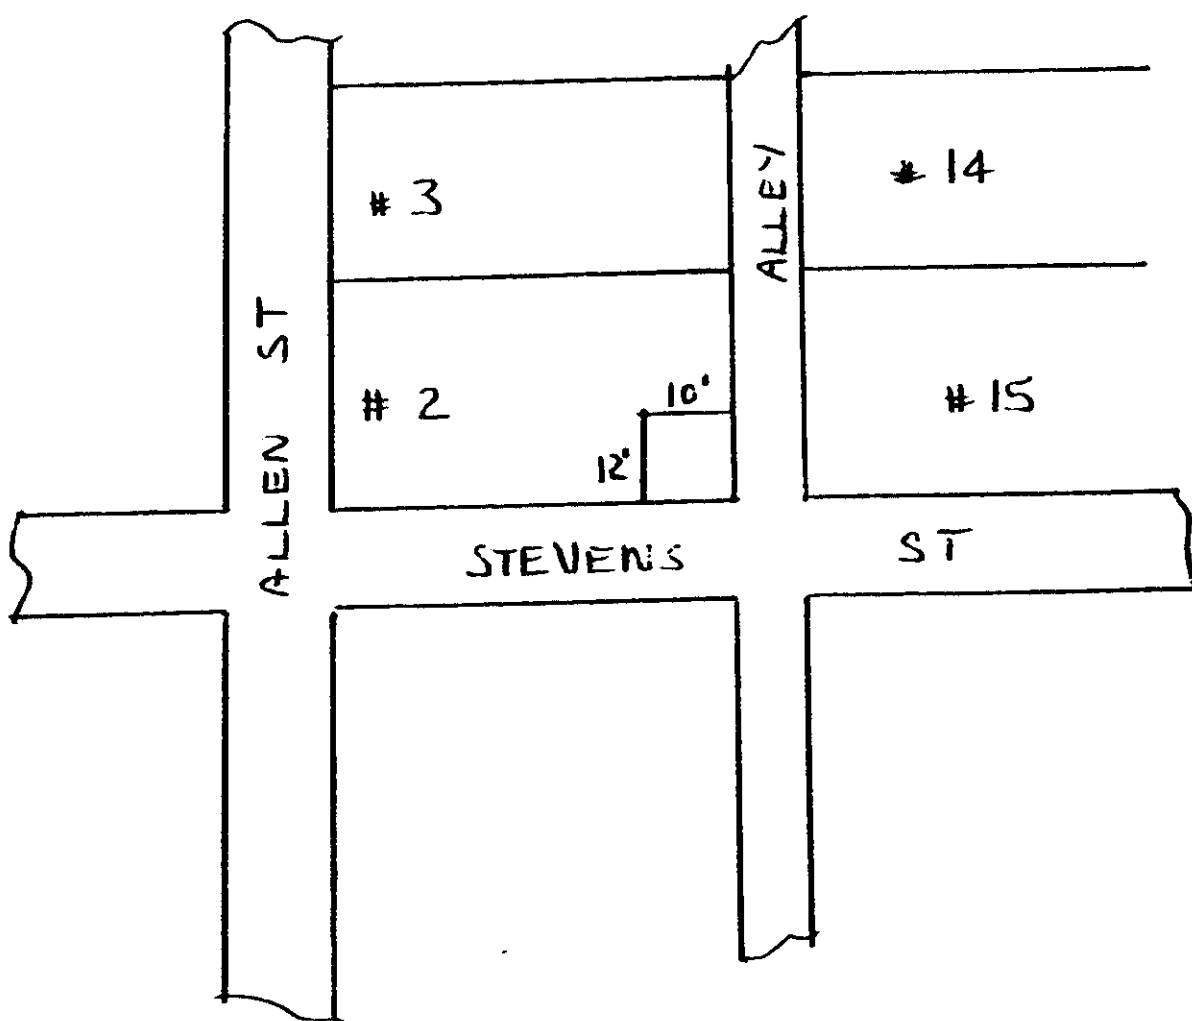

RECORDED JAN 31 1983 at 3:07 P.M.

15693

Record in the office of  
 R. M. C. for Greenville  
 on Jan. 31, 1983 at 3:07 o'clock  
 P.M. and recorded in Deed Book  
 1181 at page 661  
 R. M. C. for G. Co. S. C.

JAN 31 1983

15693

4328 RV. 21

090