


Vol 1487 Nov 1955


0783

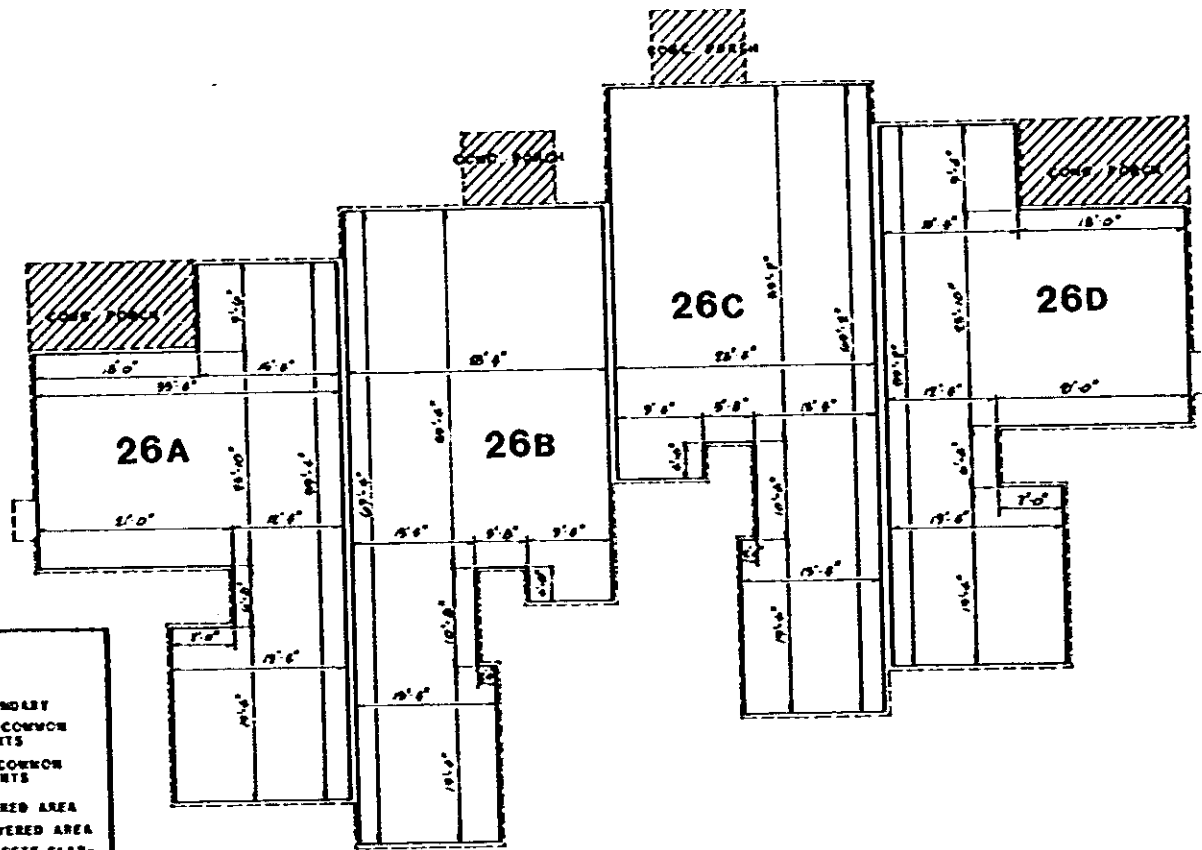

LEGEND:

- LIMIT BOUNDARY
- - - - - GENERAL COMMON ELEMENTS
- ////// LIMITED COMMON ELEMENTS
- "PORCH" DENOTES COVERED AREA
- "PATIO" DENOTES UNCOVERED AREA
- "CONC." DENOTES CONCRETE SLAB-ON-GRADE CONSTRUCTION
- "WOOD" DENOTES ABOVE-GRADE WOODEN CONSTRUCTION

FIRST FLOOR PLAN

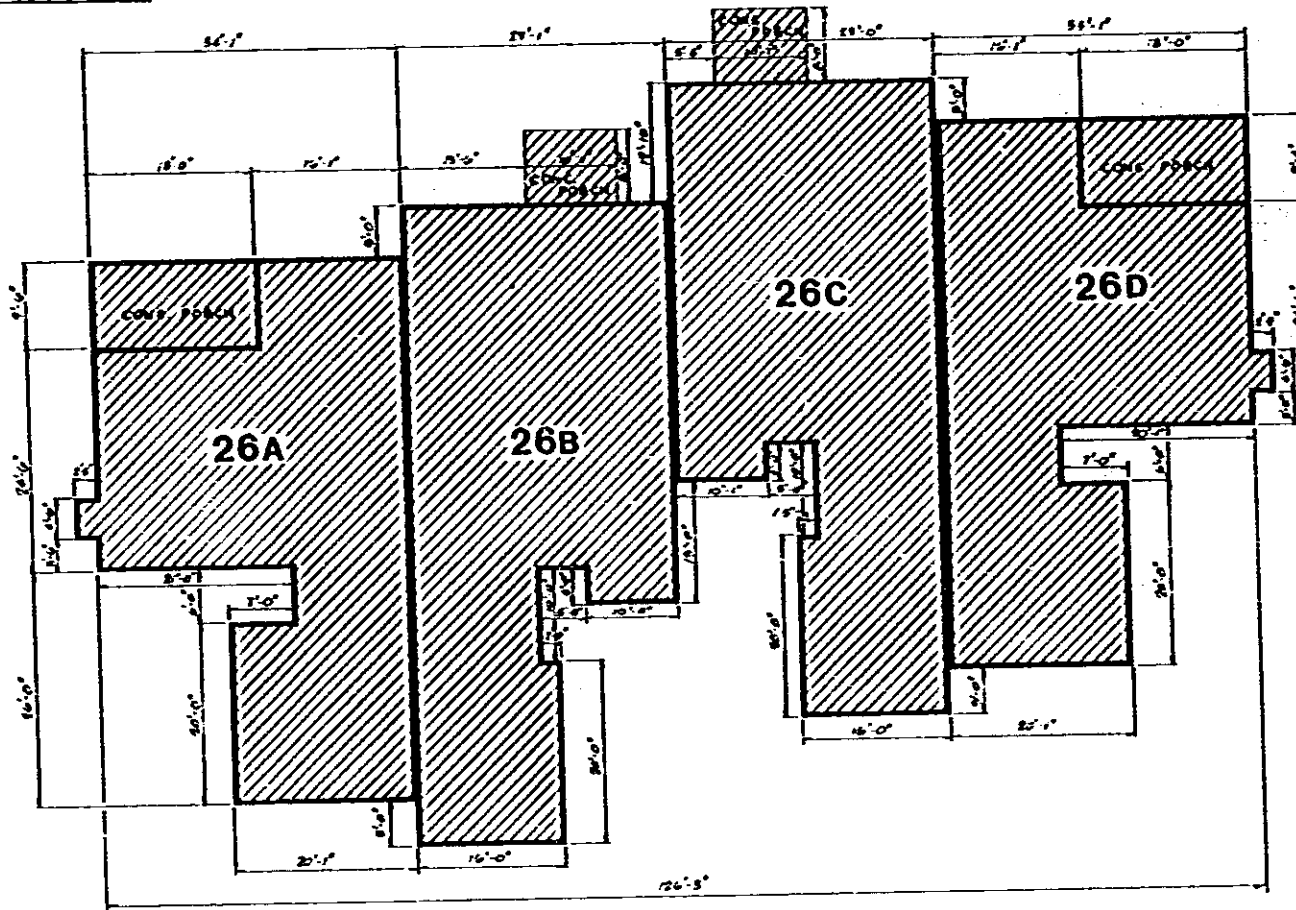

FOUNDATION PLAN

I, ORVILLE V. PLAYER III, HEREBY CERTIFY THAT THE WITHIN FLOOR PLANS ARE TRUE AND CORRECT TO THE BEST OF MY KNOWLEDGE.

Orville V. Player III
ORVILLE V. PLAYER III
S.C. REGISTRATION # 1556

BUILDING 26



SUGAR CREEK VILLAS
HORIZONTAL PROPERTY REGIME

EXHIBIT B SHEET 3



MILLER/PLAYER & ASSOCIATES
ARCHITECTS AND PLANNERS, LTD.

James B. Miller, A.I.A. / Orville V. Player, III / Robert C. Cochran



0328-734