


Name and Post Office Address of Grantor William O. & Dorothy D. Scott  
20 Maudie Street  
Greenville, SC 29605

Toll Line or Exchange Line tributary to Greenville, South Carolina  
(have) (Exchange)

The Property is bounded where the line enters and leaves this property by the property of:  
Breazeal Olivia Scott on the East  
and Scott Avenue on the South  
Authority P-43627 Classification R45C  
Area South Carolina

Approved District Manager - Distribution  
Title

Tax Book #252  
Block 1  
Lot 21.3

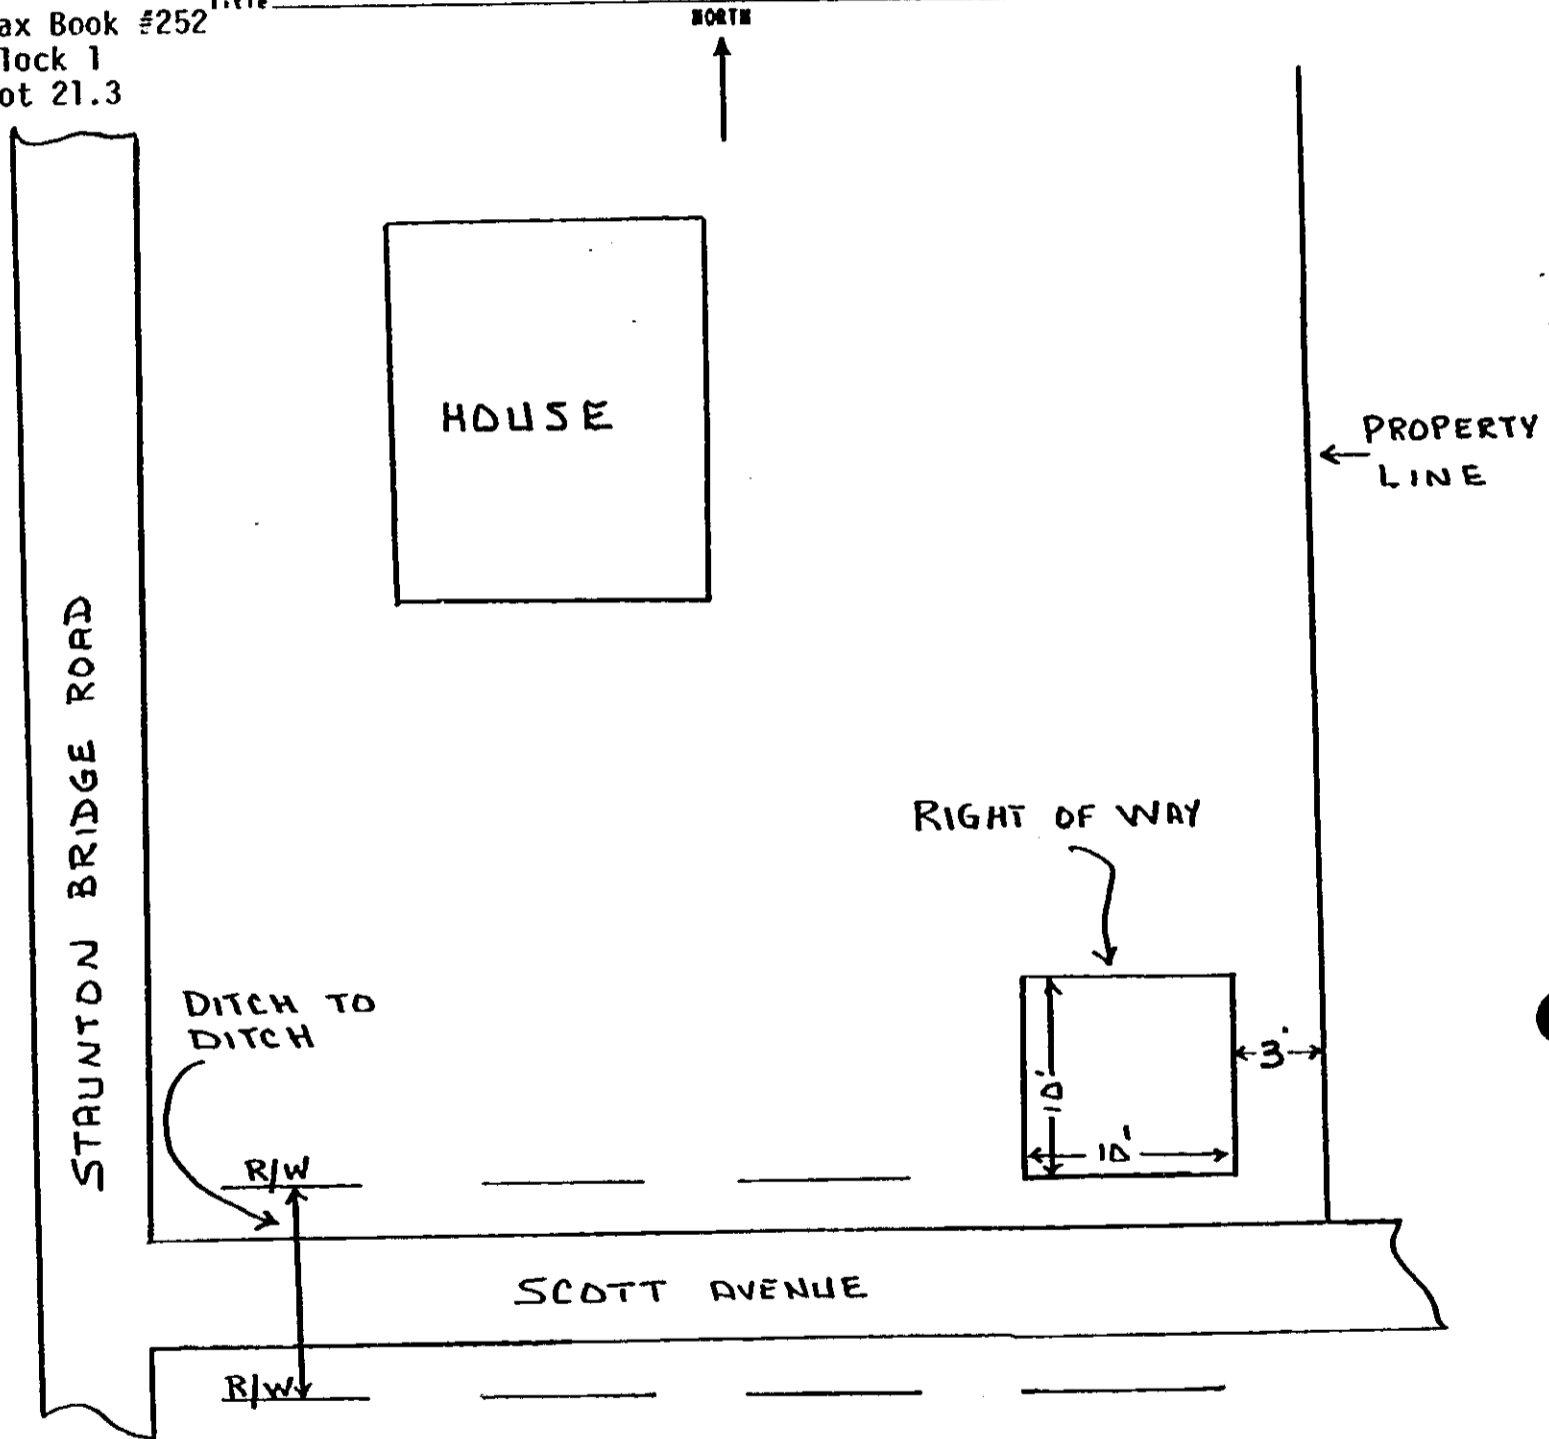

31731

RECORDED MAY 27 1983 at 11:16 A.M.

Filed for record in the office of  
the R. M. C. for Greenville  
County, S. C. at 11:16 o'clock  
A.M. May 27, 1983  
and recorded in Deed Book  
1188 at page 998  
R. M. C. for G. Co. S. C.

*Handwritten:* 31731  
MAY 27 1983  
31731