
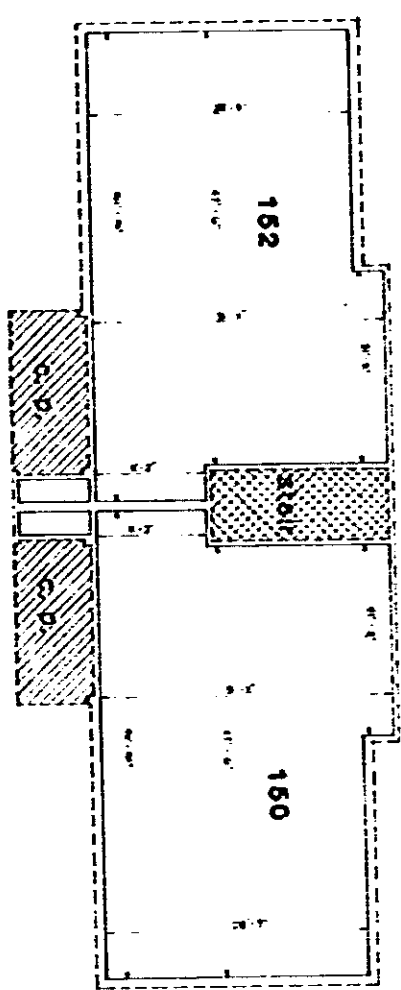


1050


Vol 1183 Page 498

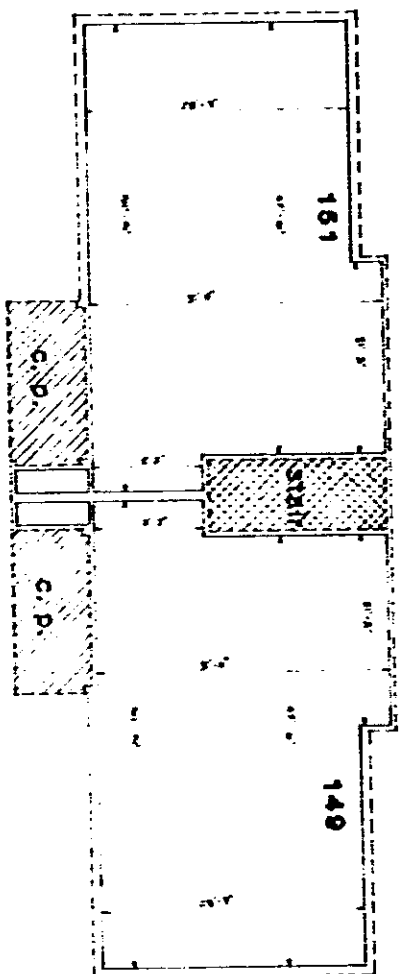

HAMPTON

LEGEND:

- EXTERIOR WALL LINE
- - - UNIT BOUNDARY
- /// GENERAL COMMON ELEMENTS
- XXXXX DENOTES CONCRETE PORCH ELEMENTS

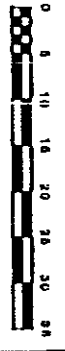

I, ORVILLE V. PLAYER, HEREBY CERTIFY THAT THE SE DRAWINGS COMPARED THE DEPOSIT AND CORRECT ON THE BASIS OF THE SURVEY OF W.A. WILLIAMS, JR. AND THAT THE AS BUILT ARCHITECTURAL DRAWINGS OF MILLER/PLAYER AND ASSOCIATES, ARCHITECTS ARE AVERAGE DIMENSIONS AND SHOULD NOT BE TAKEN AS EXACT MEASUREMENTS.

ORVILLE V. PLAYER, II
S.C. REGISTRATION #1590

MILLER/PLAYER & ASSOCIATES
ARCHITECTS AND PLANNERS . LTD.
1010 east north street . greenville, s.c.

James B. Miller, A.L.A. · Orville V. Player, II · Robert C. Cochran



RIVERBEND CONDOMINIUMS
PHASE TWO
HORIZONTAL PROPERTY REGIME
EXHIBIT B

1050