



0509

VEL 1189 PAGE 500

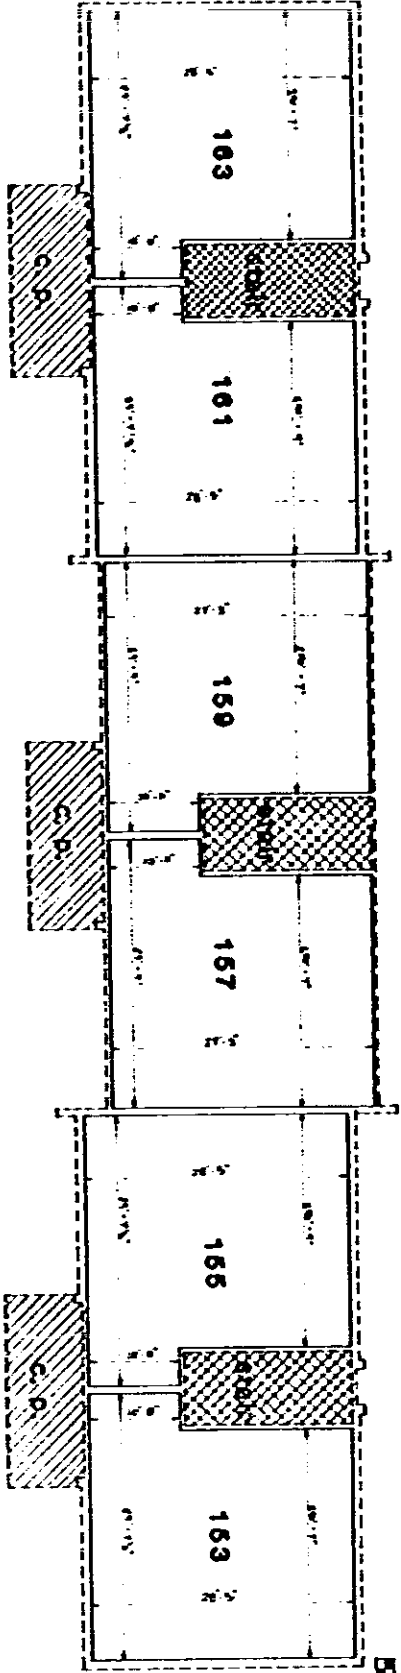

FIRST FLOOR PLAN

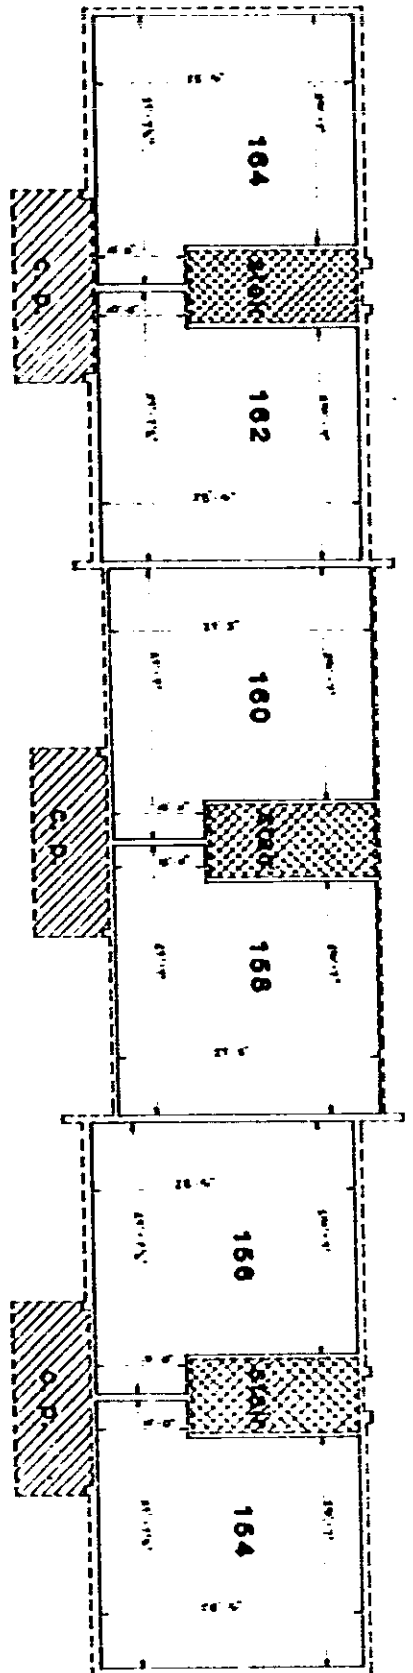

SECOND FLOOR PLAN
CALHOUN

LEGEND:

- EXTERIOR WALL LINE
- - - UNIT BOUNDARY
- /// GENERAL COMMON ELEMENTS
- XXXX LIMITED COMMON ELEMENTS
- C. P. DENOTES CONCRETE PORCH

I, ORVILLE V. PLAYER, A REGISTERED PROFESSIONAL ARCHITECT, HEREBY CERTIFY THAT THE SEVEN DRAWINGS COMPOSING THIS EXHIBIT ARE CORRECT ON THE BASIS OF THE SURVEY OF W.S. WELLS, JR. AND THAT THE AS BUILT ARCHITECTURAL DRAWINGS OF MILLER/PLAYER AND ASSOCIATES, ARCHITECTS ARE AVERAGE DIMENSIONS AND SHOULD NOT BE TAKEN AS EXACT MEASUREMENTS.

Orville V. Player
ORVILLE V. PLAYER, A
S.C. REGISTRATION #1189

6	RIVERBEND CONDOMINIUMS PHASE TWO HORIZONTAL PROPERTY REGIME EXHIBIT B		MILLER/PLAYER & ASSOCIATES ARCHITECTS AND PLANNERS, LTD. 1010 east north street, greenville, s.c. <small>James B. Miller, A.L.A. / Orville V. Player, III / Robert C. Cochran</small>	
	<p style="text-align: right;">7328-11-2</p>			