



1189

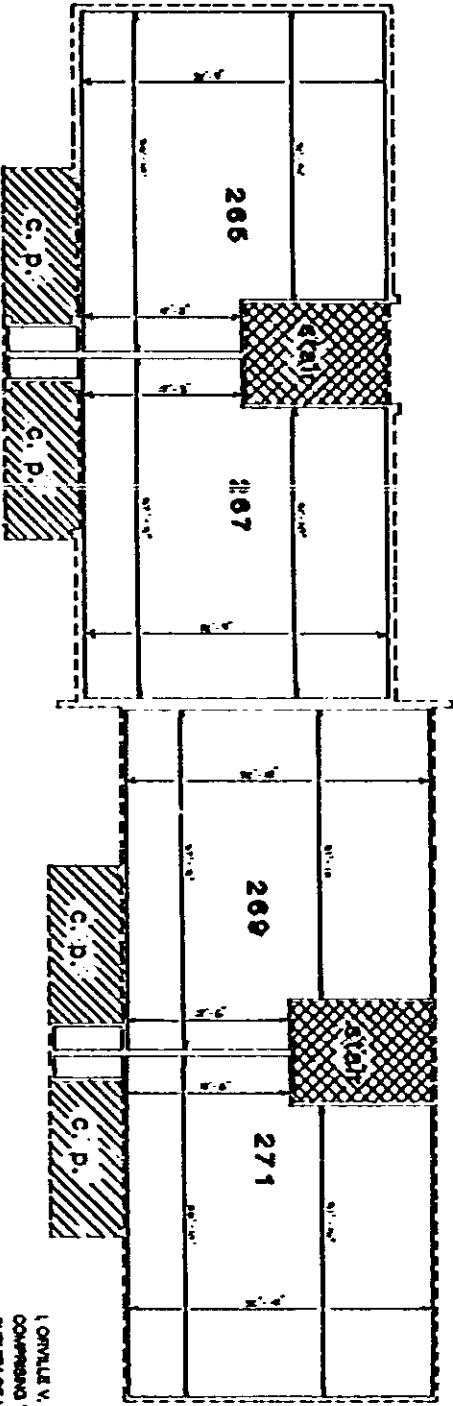


FIRST FLOOR PLAN

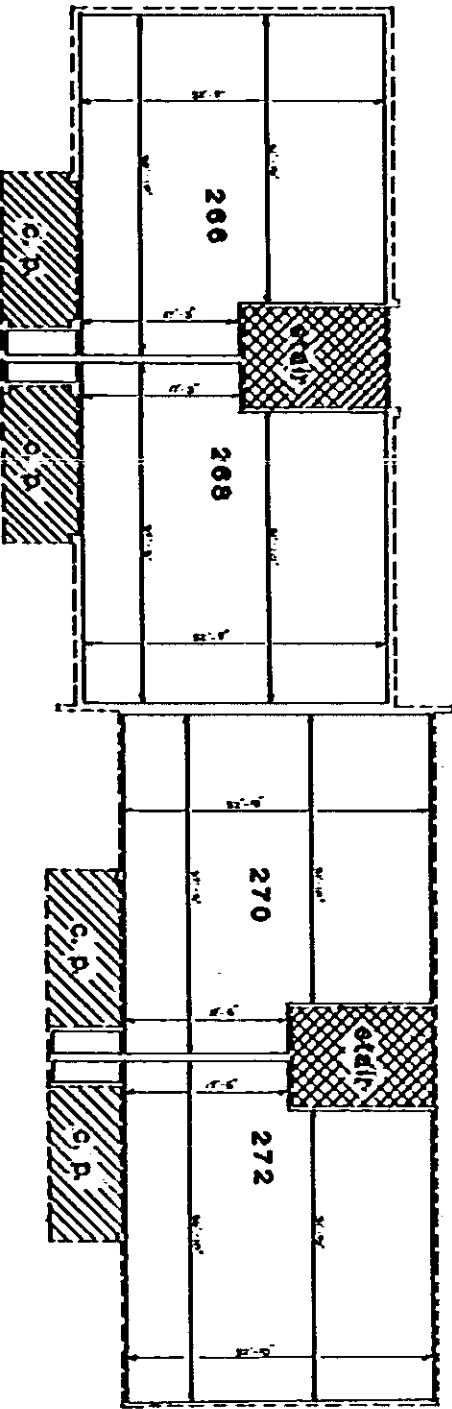

SECOND FLOOR PLAN
BERKELEY

LEGEND:

- EXTENSION WALL LINE
- UNIT BOUNDARY
- GENERAL COMMON ELEMENTS
- LIMITED COMMON ELEMENTS
- C.P. DENOTES CONCRETE PORCH

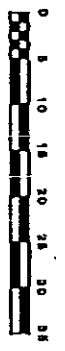

I, ORVILLE V. PLAYER, HEREBY CERTIFY THAT THE SAID DRAWINGS COMPARED THE EXISTING ARE CORRECT ON THE BASIS OF THE SURVEY OF W.A. WILLIAMS, JR. AND THAT THE SAID ARCHITECTURAL DRAWINGS OF MILLER/PLAYER AND ASSOCIATES ARCHITECTS ARE AVERAGE DIMENSIONS AND SHOULD NOT BE TAKEN AS EXACT MEASUREMENTS.

ORVILLE V. PLAYER, II
S.D. REGISTRATION # 1000

33	RIVERBEND CONDOMINIUMS PHASE TWO HORIZONTAL PROPERTY REGIME EXHIBIT B		MILLER/PLAYER & ASSOCIATES ARCHITECTS AND PLANNERS, LTD. 1010 east north street . greenville, s.c. James B. Miller, A.L.A. / Orville V. Player, II	
----	--	--	--	--

1189